

MISSISSIPPI DEPARTMENT OF NATURAL RESOURCES
Bureau of Land and Water Resources

P.O. Box 10631
Jackson, Mississippi 39209
WATER WELL DRILLERS LOG

Jackson

COUNTY WELL LOCATED	
WELL NUMBER	CODED
<i>A 2017</i>	
DATE WELL COMPLETED	
<i>5-13-88</i>	

PERMIT NUMBER
NAME OF DRILLING FIRM
<i>Coast Water Well Serv.</i>

NAME & MAILING ADDRESS OF LANDOWNER			
<i>Roy Tanner</i>			
<i>23713 Old Blue</i>			
<i>Ocean Springs</i>			
WELL LOCATION:	SEC	TOWNSHIP	RANGE
	<i>21</i>	<i>4</i>	<i>8</i>
		<i>N</i>	<i>E</i>
		<i>S</i>	<i>W</i>
DISTANCE	DIRECTION	NEAREST TOWN	
<i>6</i>	<i>NE</i>	<i>LARUE</i>	
Miles	of		
OTHER LANDMARK			
WELL PURPOSE: Home, Irrigation, Municipal, Industrial, Fish Pond, etc.			
<i>home</i>			

PUMP DATA		
PUMP TYPE (Circle One):		
Submersible,	Turbine,	<input checked="" type="radio"/> Jet
Flowing Well, Other (Describe) _____		
POWER TYPE (Circle One):		
<input checked="" type="radio"/> Electric,	Tractor,	Diesel, Gasoline, Butane,
Other (Describe) _____		
Pump Capacity (GPM)	No. of Stages	Setting Depth
<i>8</i>	<i>2</i>	<i>—</i>
		FT.
PUMP TEST		
Well yielded _____ GPM with		
a drawdown of _____ ft.		
after _____ hours of pumping		


WELL DATA		
Well Depth	Casing Diameter (In.)	Casing Length (Ft.)
<i>370'</i>	<i>2"</i>	<i>360'</i>
Type of Casing	Hole Depth	Depth to Static Water Level
<i>PVC</i>	<i>375'</i>	<i>70'</i>
TYPE OF COMPLETION: (Circle One or More):		
<input checked="" type="checkbox"/> Gravel Packed,	<input type="checkbox"/> Underreamed,	<input type="checkbox"/> Telescoped,
<input checked="" type="checkbox"/> Natural Development,	<input type="checkbox"/> Open Hole,	<input type="checkbox"/> Other
(Describe) _____		
Top of Lap Pipe or Reduction in Casing		
FEET	IF TELESCOPED OR MORE THAN ONE SCREEN: USE BACK PAGE	

LOG DATA	
TYPE OF LOG RUN (Circle One):	
<input type="checkbox"/> Electric, Gamma Ray, Density, Sonic, Neutron,	<input checked="" type="checkbox"/> No Log Run,
Other (Describe) _____	
Name of Organization Running Log	

SCREEN DATA		
Diameter - Inches	Length - Feet	Slot Size - Inches
<i>2"</i>	<i>10'</i>	<i>.008</i>
Screen Type	Depth to Bottom - Feet	
<i>PVC</i>	<i>370'</i>	

GEOLOGIC DATA (Office Use Only)			
Surface Elev.	Geologic Unit	Unit Thickness	Depth to Top
Subs. SWL	Date	Analysis	Aquifer Test
Driller's Remarks			

DESCRIPTION OF FORMATIONS ENCOUNTERED	FROM	TO
<i>Top Soil</i>	<i>0</i>	<i>1</i>
<i>Red Clay</i>	<i>1</i>	<i>9</i>
<i>Red Med. Sand</i>	<i>9</i>	<i>18</i>
<i>White Clay</i>	<i>18</i>	<i>21</i>
<i>Blue Clay</i>	<i>21</i>	<i>60</i>
<i>Gray Med. Sand</i>	<i>60</i>	<i>80</i>
<i>Blue Clay</i>	<i>80</i>	<i>90</i>
<i>Gray Coarse Sand</i>	<i>90</i>	<i>129</i>
<i>Wood</i>		<i>129</i>
<i>Blue Clay</i>	<i>129</i>	<i>332</i>
<i>Gray Coarse Sand</i>	<i>332</i>	<i>375</i>

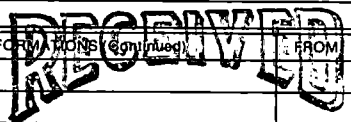

NOV 17 1988


Department of Natural Resources
Bureau of Land & Water Resources

FORM NO. 8 (Continued)	FROM	TO

IF MORE SPACE IS NEEDED, USE BACK

If well telescopes please sketch and show depths.

GROUND LEVEL

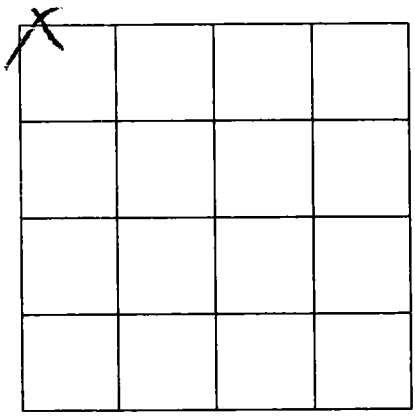

SECTION 21

Please indicate well location X.

ADDITIONAL INFORMATION

Lined area for additional information.

If more than one screen, show location of each on sketch.