

MISSISSIPPI DEPARTMENT OF NATURAL RESOURCES

Bureau of Land and Water Resources

P.O. Box 10631

Jackson, Mississippi 39209

WATER WELL DRILLERS LOG

COUNTY WELL LOCATED JACKSON	
WELL NUMBER A 2018	CODED
DATE WELL COMPLETED 22 NOV '88	

PERMIT NUMBER 0-485
NAME OF DRILLING FIRM CORETEC
WRIGHT - STOUT

NAME & MAILING ADDRESS OF LANDOWNER MR. ANDY PREVOST		
RFD WIRE ROAD		
Biloxi, Ms. 39532		
WELL LOCATION: SEC	TOWNSHIP	RANGE
10	4	9
	N	W
DISTANCE	DIRECTION	NEAREST TOWN
10 Miles	NORTH	LARUE
OTHER LANDMARK INTERSECTION OF WIRE Rd, AND LARUE - DANTZIER Rd		
WELL PURPOSE: Home, Irrigation, Municipal, Industrial, Fish Pond, etc. HUNTING CAMP		

PUMP DATA		
PUMP TYPE (Circle One): Submersible, Turbine, Jet Flowing Well, Other (Describe) _____		
POWER TYPE (Circle One): Electric , Tractor, Diesel, Gasoline, Butane, Other (Describe) _____		
Pump Capacity (GPM)	No. of Stages	Setting Depth
22	2	100' FT.
PUMP TEST		
Well yielded 12 GPM with a drawdown of 30' ft. after 2 hours of pumping		

WELL DATA		
Well Depth 200'	Casing Diameter (In.) 2"	Casing Length (Ft.) 190'
Type of Casing PVC	Hole Depth 203'	Depth to Static Water Level 62'
TYPE OF COMPLETION: (Circle One or More): Natural Development , Gravel Packed, Underreamed, Telescoped, Open Hole, Other (Describe) _____		
Top of Lap Pipe or Reduction in Casing FEET IF TELESKOPED OR MORE THAN ONE SCREEN: USE BACK PAGE		

LOG DATA	
TYPE OF LOG RUN (Circle One): Electric, Gamma Ray, Density, Sonic, No Log Run , Other (Describe) _____	
Name of Organization Running Log N/A	

SCREEN DATA		
Diameter - Inches 2"	Length - Feet 10'	Slot Size - Inches #10
Screen Type PVC (cut)	Depth to Bottom - Feet 190'-200'	

GEOLOGIC DATA (Office Use Only)			
Surface Elev.	Geologic Unit	Unit Thickness	Depth to Top
Subs. SWL	Date	Analysis	Aquifer Test

Driller's Remarks


RECEIVED

DESCRIPTION OF FORMATIONS ENCOUNTERED	FROM	TO	FORMATIONS (Continued)	
			FROM	TO
Top Soil	0	1	FINE GRAY SAND	145 157
ORANGE VISCIOUS CLAY	1	10	MEDIUM GRAY SAND	157 175
COURSE WHITE SAND	10	12	DRY SAND	175 203
GREY POTTERS CLAY	12	25		
BLUE GUMBO MUD	25	40		
GREY MUD + FINE SAND	40	47		
HARD GRAY CLAY	47	51		
SOFT GRAY CLAY + SAND	51	101		
HARD BLUE-GREEN CLAY	101	115		
FINE - MED. SAND	115	130		
HARD GUMBO MUD	130	145		

IF MORE SPACE IS NEEDED, USE BACK

If well telescopes please sketch and show depths.

GROUND LEVEL

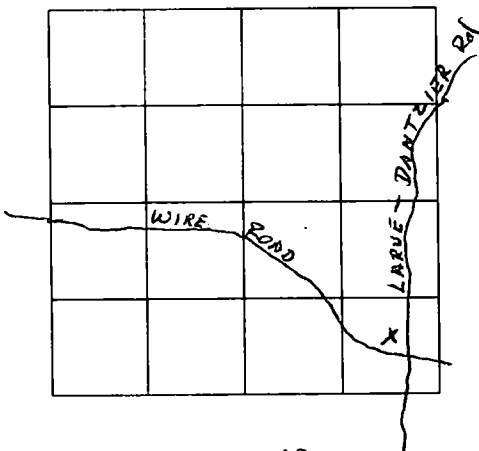

SECTION 10

Please indicate well location X.

ADDITIONAL INFORMATION

If more than one screen, show location of each on sketch.