

59

MISSISSIPPI  
 BOARD OF WATER COMMISSIONERS  
 416 North State Street  
 Jackson, Mississippi 39201

WATER WELL DRILLERS LOG

Jackson
Ble
7-67

7-29 1967 date well completed  
 Constant Water Well Drilling firm name  
 Jackson county well located

LANDOWNER: J.C. Ball  
 & Richard Cushing  
 807 11th St.  
 (mailing address)  
 Pascagoula, Miss.  
 WELL LOCATION:  
 Sec. 4 N R 7 E  
 S W  
 10 miles NW of Wade  
 (distance) (direction) (nearest town)

description of formations encountered	from	to
Red Clay	0	18
Sand fine - coarse	18	50
Blue Clay & shale with shell	50	183
Sand fine med	183	220

WELL PURPOSE: Camp  
 (home, irrigation, municipal, industrial)

- WELL COMPLETION DATA:
- (1) diameter (inches) 2
  - (2) total depth (feet) 220
  - (3) static water level (feet) 15 below top of ground.
  - (4) casing 2" galv. 210'  
 (material) (depth)  
2"  
 (size) if telescope see back.
  - (5) screen 10' 210  
 (length) (depth to top)  
2" Plastic  
 (size) (material)
  - (6) pump None 20  
 (HP) (yield gpm)  
None  
 (type power)
  - (7) electric log NO  
 (yes or no)  
 (organization running log)
  - (8) how well bottom plugged Back wash valve


DRILLERS REMARKS:



If well telescopes please sketch and show depths.

SW 1/4

GROUND LEVEL

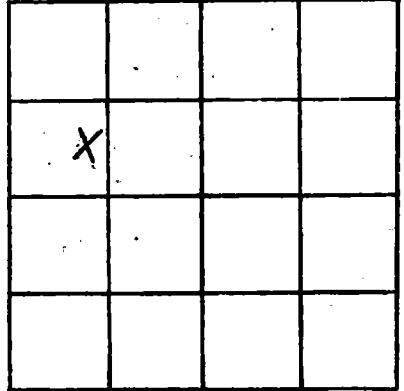

3B  
SECTION ~~37~~

Please indicate well location X.

ADDITIONAL INFORMATION

Lined area for additional information.

If more than one screen, show locations of each on sketch.