

59

Jackson  
B 7  
7-67

MISSISSIPPI  
BOARD OF WATER COMMISSIONERS  
416 North State Street  
Jackson, Mississippi 39201

WATER WELL DRILLERS LOG

7-25 1967 Coast Water Well Drilling Jackson  
date well completed firm name county well located

LANDOWNER: Robert Lucas  
Lucas Miss  
Cedar Creek Estates  
(mailing address)


description of formations	depth	
	from	to
Med. sand	0	54
Blue clay	54	176
Med. sand	176	186

WELL LOCATION:  
sec 38 T 4 N R 7 E  
10 miles N.W. of Wade  
(distance) (direction) (nearest town)

WELL PURPOSE: Private  
(home, irrigation, municipal, industrial)

WELL COMPLETION DATA:

- (1) diameter (inches) 2"
- (2) total depth (feet) 186
- (3) static water level (feet) 10 below top of ground.
- (4) casing galv. 176  
(material) (depth)  
(size) If telescope see back.
- (5) screen 10' 176"  
(length) (depth to top)  
2" galv.  
(size) (material)
- (6) pump 1/2 Plastic 10  
(HP) (yield gpm)  
Elect.  
(type power)
- (7) electric log NO  
(yes or no)  
(organization running log)
- (8) how well bottom plugged Backward  
value

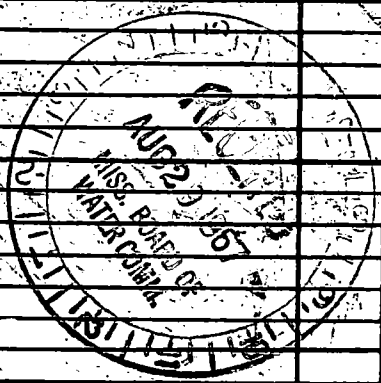

DRILLERS REMARKS:

If well telescopes please sketch and show depths.

GROUND LEVEL

SW NW

X			

SECTION 3A

Please indicate well location X.

ADDITIONAL INFORMATION

If more than one screen, show locations of each on sketch.