

JACKSON  
 B 9  
 12-11-68

MISSISSIPPI  
 BOARD OF WATER COMMISSIONERS  
 416 North State Street  
 Jackson, Mississippi 39201

CODED

WATER WELL DRILLERS LOG

12-11 1968 Arnold Anderson Jackson  
 date well completed firm name county well located

LANDOWNER: J. O. Whittington  
Route 7 Ocean Springs  
Miss.  
 (mailing address)

description of formations encountered	from	to
TOP Soil	0	4
Red Sandy clay	4	14
FIN Red sand	14	32
Red clay	32	46
Fin sand	46	62
COARSE SAND	62	71

WELL LOCATION:  
 sec 28 T 4 S R 7  
12 miles N of Vandouver  
 (distance) (direction) (nearest town)

WELL PURPOSE: Home  
 (home, irrigation, municipal, industrial)

- WELL COMPLETION DATA:
- (1) diameter (inches) 2
  - (2) total depth (feet) 71
  - (3) static water level (feet) 50 below top of ground.
  - (4) casing Plst 65  
 (material) (depth)
  - (size) if telescope see back.
  - (5) screen 6 65  
 (length) (depth to top)
  - 2" Plastic  
 (size) (material)
  - (6) pump 3/4 8  
 (HP) (yield gpm)
  - Electric  
 (type power)
  - (7) electric log \_\_\_\_\_  
 (yes or no)
  - \_\_\_\_\_  
 (organization running log)
  - (8) how well bottom plugged Backwash valve


DRILLERS REMARKS:

MAR 20 1969

MISS. DEP. OF WATER CONTROL

If well telescopes please sketch and show depths.

GROUND LEVEL

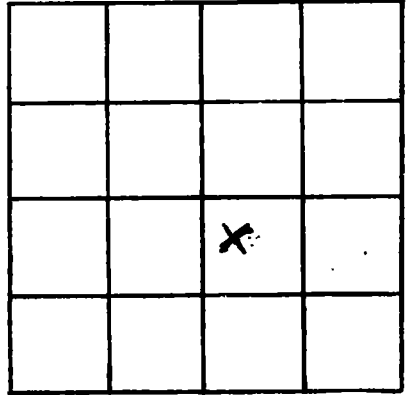

SECTION 28

Please indicate well location X.

ADDITIONAL INFORMATION

If more than one screen, show locations of each on sketch.