

CODED

MISSISSIPPI BOARD OF WATER COMMISSIONERS
416 North State Street
Jackson, Mississippi 39201

WATER WELL DRILLERS LOG

Jackson
B10
7-17-69

July 17 1969 M. G. H. Well Co. Jackson
date well completed firm name county well located

LANDOWNER:

Edd Owens

Saucier, Miss.
(mailing address)

WELL LOCATION:

sec 24 T 4 N R 7 E
5 miles SW of road
(distance) (direction) (nearest town)

WELL PURPOSE: none
(home, irrigation, municipal, industrial)

WELL COMPLETION DATA:

- (1) diameter (inches) 2"
- (2) total depth (feet) 262'
- (3) static water level (feet) 0 ^{below} above top of ground.
- (4) casing Galv. 252'
(material) (depth)
_____ if telescope see back.
(size)
- (5) screen 10' 252'
(length) (depth to top)
2" Plastic
(size) (material) 30
- (6) pump _____ 30
(HP) (yield gpm)
_____ (type power)
- (7) electric log _____
(yes or no)
_____ (organization running log)
- (8) how well bottom plugged Backwash valve

description of formations encountered

description of formations encountered	from	to
<u>Yellow Sand</u>	<u>0</u>	<u>15</u>
<u>Blue Clay</u>	<u>15</u>	<u>30</u>
<u>Sand</u>	<u>30</u>	<u>40</u>
<u>Blue Clay</u>	<u>40</u>	<u>80</u>
<u>Sand</u>	<u>80</u>	<u>200</u>
<u>Blue Clay</u>	<u>200</u>	<u>210</u>
<u>Sand</u>	<u>210</u>	<u>245</u>
<u>Sand</u>	<u>245</u>	<u>262</u>


CODED

DRILLERS REMARKS:

JUL 23 1969

If well telescopes please sketch and show depths.

GROUND LEVEL

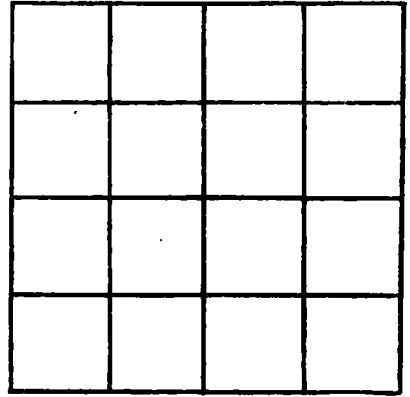

SECTION 24

Please indicate well location X.

ADDITIONAL INFORMATION

If more than one screen, show locations of each on sketch.