

Jackson
 B11
 11-7-67

MISSISSIPPI
 BOARD OF WATER COMMISSIONERS
 416 North State Street
 Jackson, Mississippi 39201

CODED

WATER WELL DRILLERS LOG

Nov 7 1967 Colville Water Supply Jackson
 d. of well completed firm name county well located

LANDOWNER: L. P. Johnson
 Carlaw Creek Estates
 Wade Miss
 (mailing address)

description of formations encountered	depth	
	from	to
Sand	0	10
Clay	10	22
sand	22	50
clay	50	154
sand	154	161

WELL LOCATION:
 sec 12 T 4 N R 7 E
 9 miles NW of Wade
 (distance) (direction) (nearest town)

WELL PURPOSE: Pump
 (home, irrigation, municipal, industrial)

- WELL COMPLETION DATA:
- (1) diameter (inches) 2
 - (2) total depth (feet) 161
 - (3) static water level (feet) 5 ^{below} top of ground
 - (4) casing galv (material), (depth)
 (size) If telescope see back.
 - (5) screen 5 (length), 156 (depth to top)
 2 (size), stainless (material)
 - (6) pump 1/2 (HP), 6 (yield gpm)
 elec (type power)
 - (7) electric log no (yes or no)
 (organization running log)
 - (8) how well bottom plugged B.P. Kelly


JAN 8 1979

MISS. Bd. of
 WATER COMMISSIONERS

DRILLERS REMARKS:

If well telescopes please sketch and show depths.

GROUND LEVEL

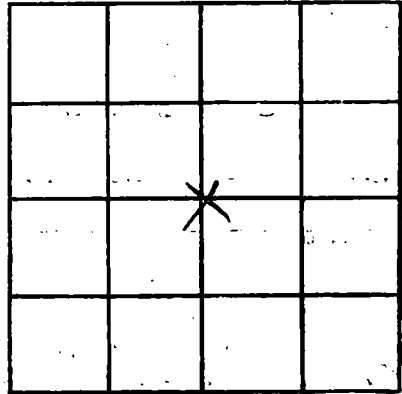

irregular sec. 12
SECTION _____

Please indicate well location X.

ADDITIONAL INFORMATION

If more than one screen, show locations of each on sketch.