

JACKSON

B 13

5-8-71

MISSISSIPPI BOARD OF WATER COMMISSIONERS
416 North State Street
Jackson, Mississippi 39201

CODED

WATER WELL DRILLERS LOG

May 8 1970 Colville Water Supply Jackson
date well completed firm name county well located

LANDOWNER	description of formations encountered	from	to
Ted and Lester White			
Vanclave Miss (mailing address)	Clay	0	16
WELL LOCATION:	Sap	16	60
sec. 21 T. 4 N R. 7 E (S) (W)	Clay	60	66
11 miles North of Vanc. (distance) (direction) (nearest town)	Clay	66	82
WELL PURPOSE: home (home, irrigation, municipal, industrial)	Sand	82	92
WELL COMPLETION DATA:	Clay	92	230
(1) diameter (inches) 2	Sand	230	242
(2) total depth (feet) 242			
(3) static water level (feet) 24 below top of ground above			
(4) casing galv. 227 (material) (depth)			
(size) if telescope see back.			
(5) screen 15" 227 (length) (depth to top)			
2" Stain (size) (material)			
(6) pump (HP) (yield gpm)			
(type power)			
(7) electric log No (yes or no)			
(organization running log)			
(8) how well bottom plugged B.P. Valve			
DRILLERS REMARKS:			


CODED

JUL 13 1971

MISS. BD. OF
WATER COMM.

If well telescopes please sketch and show depths.

GROUND LEVEL

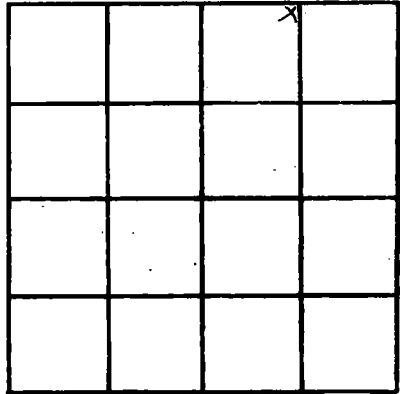

SECTION 21

Please indicate well location X.

ADDITIONAL INFORMATION

If more than one screen, show locations of each on sketch.