

JACKSON
 B14
 6-15-71

MISSISSIPPI
 BOARD OF WATER COMMISSIONERS
 416 North State Street
 Jackson, Mississippi 39201

CODED

WATER WELL DRILLERS LOG

June 15 1971 data well completed
 Colville Water Supply firm name
 Jackson county well located

LANDOWNER: <u>Denzil Harrison</u>	description of formations encountered	from	to
<u>Cedar Creek Min</u> (mailing address)	<u>clay</u> <u>sand</u> <u>clay</u> <u>sand</u>	<u>0</u> <u>6</u> <u>42</u> <u>200</u>	<u>6</u> <u>42</u> <u>200</u> <u>278</u>
WELL LOCATION:			
sec. <u>38</u> T <u>9</u> N R <u>7</u> E <u>21</u> miles <u>NW</u> of <u>M.P.</u> (distance) (direction) (nearest town)			
WELL PURPOSE: <u>Camp</u> (home, irrigation, municipal, industrial)			
WELL COMPLETION DATA:			
(1) diameter (inches) <u>2</u>			
(2) total depth (feet) <u>228</u>			
(3) static water level (feet) <u>5</u> ^{below} _{above} top of ground <u>plastic</u>			
(4) casing <u>plastic</u> <u>223</u> (material) (depth)			
(size) if telescope see back.			
(5) screen <u>5'</u> <u>223</u> (length) (depth to top)			
<u>2"</u> <u>plastic</u> (size) (material)			
(6) pump _____ (HP) _____ (yield gpm)			
(type power)			
(7) electric log <u>no</u> (yes or no)			
(organization running log)			
(8) how well bottom plugged <u>B.P. Valve</u>			
DRILLERS REMARKS: <u>Pump installed by owner</u>			


CODED

JUL 10 1971

MISS. BD. OF
 WATER COMM.

If well telescopes please sketch and show depths.

GROUND LEVEL

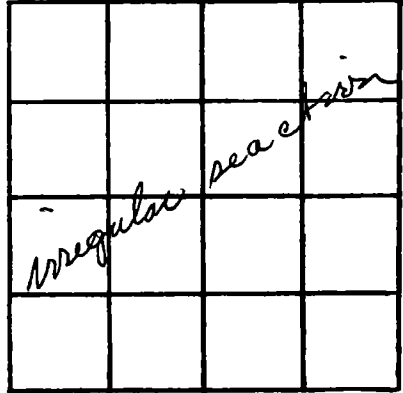

SECTION 38

Please indicate well location X.

ADDITIONAL INFORMATION

If more than one screen, show locations of each on sketch.