

JACKSON
 B 19
 8-22-72


MISSISSIPPI
 BOARD OF WATER COMMISSIONERS
 416 North State Street
 Jackson, Mississippi 39201
 WATER WELL DRILLERS LOG

Aug 22 1972 Calville Jackson
 date well completed firm name county well located

LANDOWNER: <u>Murray Evans</u>	description of formations encountered	from	to
<u>Cedar Creek</u> (mailing address)			
WELL LOCATION: sec <u>12</u> T <u>4</u> N R <u>7</u> E <u>22</u> miles <u>NW</u> of <u>MP</u> (distance) (direction) (nearest town)	<u>sand</u> 15 <u>58</u>		
WELL PURPOSE: <u>Camp</u> (home, irrigation, municipal, industrial)	<u>clay</u> 58 <u>170</u>		
WELL COMPLETION DATA: (1) diameter (inches) <u>2</u>	<u>sand</u> 170 <u>175</u>		
(2) total depth (feet) <u>175</u>			
(3) static water level (feet) <u>5</u> <u>below</u> top of ground. <u>above</u>			
(4) casing <u>galv</u> , <u>170</u> , (material) (depth)			
(size) If telescope see back.			
(5) screen <u>5'</u> , <u>170</u> (length) (depth to top)			
(size), <u>stainless</u> (material)			
(6) pump <u>1</u> , <u>10</u> (HP) (yield gpm)			
<u>elec</u> (type power)			
(7) electric log <u>no</u> (yes or no)			
(organization running log)			
(8) how well bottom plugged <u>BP Valve</u>			
DRILLERS REMARKS:			

If well telescopes please sketch and show depths.

GROUND LEVEL

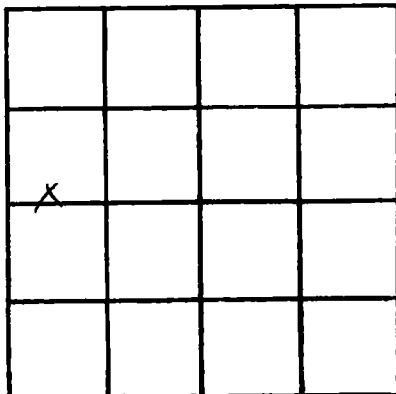

SECTION 12

Please indicate well location X.

ADDITIONAL INFORMATION

A series of horizontal lines for writing additional information, starting below the 'ADDITIONAL INFORMATION' header and extending to the bottom of the page.

If more than one screen, show locations of each on sketch.