

Jackson
BZZ
5-26-81

MISSISSIPPI
BOARD OF WATER COMMISSIONERS
416 North State Street
Jackson, Mississippi 39201

CODED

WATER WELL DRILLERS LOG

5-26 1981 RD & HWell Co JACKSON
date well completed firm name county well located

LANDOWNER: C. E. ELLIOTT
2274 HALL MILL
Rd Mobile AL 36608
(mailing address)

description of formations encountered	from	to
SAND & CLAY	0	45
WATER SAND	45	55
HARD BLUE CLAY	55	140
Muddy SAND	140	165
HARD WATER SAND	165	185

WELL LOCATION:
sec. 38 T. 4 N. R. 7 E. S. 3 W. WADE
2" miles (distance) (direction) (nearest town)

WELL PURPOSE: Home
(home, irrigation, municipal, industrial)

- WELL COMPLETION DATA:
- (1) diameter (inches) 2"
 - (2) total depth (feet) 186
 - (3) static water level (feet) _____ below above top of ground.
 - (4) casing P.U.C. 175 FT
(material) (depth)
2"
(size) If telescope see back.
 - (5) screen 10 FT. 175 FT
(length) (depth to top)
2" P.U.C.
(size) (material)
 - (6) pump 1/2 12
(HP) (yield gpm)
Elec.
(type power)
 - (7) electric log NO
(yes or no)
 - (8) how well bottom plugged _____
2" WASH VALVE

CODED


DEPT. OF NATURAL RESOURCES
BUREAU OF LAND & WATER RESOURCES

JUN 2 - 1981
RECEIVED

DRILLERS REMARKS:
WATER IN TOP
SAND. GOT BAD
SMELL & TASTE

If well telescopes please
sketch and show depths.

GROUND LEVEL

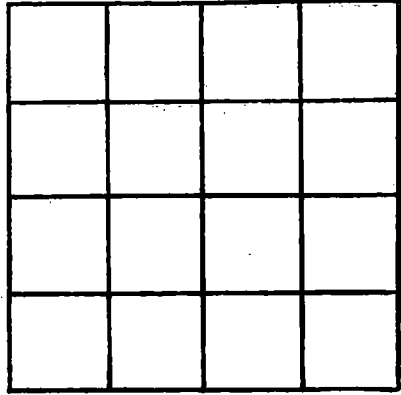

SECTION _____

Please indicate well location X.

ADDITIONAL INFORMATION

If more than one screen,
show locations of each on sketch.