

MISSISSIPPI DEPARTMENT OF NATURAL RESOURCES

Bureau of Land and Water Resources

Southport Mall

P.O. Box 10631

Jackson, Mississippi 39209 **CODED**

**WATER WELL DRILLERS LOG**

B 24  
 JACKSON CO.  
 10-12-84

19 10-12-84 JTY/OSL Jackson  
 date well completed firm name county well located

LANDOWNER: Ronald K. Huel  
P.O. Box 1087  
Escatawpa, MS 39552  
 (mailing address)

description of formations encountered	from	to
Top Soil & Sandy Clay	0	20
Sandy Clay	20	40
Clay	40	60
Fine Sand	60	100
Sandy Clay	100	120
Clay	120	200
10' Red Sand	200	210
Clay	210	300
Conga Sand	300	302
Clay	302	460
Sand	460	505

WELL LOCATION:  
 S 5 sec 4 T 4 N R 7 E  
20 miles S 20 of Bucedale  
 (distance) (direction) (nearest town)

WELL PURPOSE:  
 (home, irrigation, municipal, industrial)

WELL COMPLETION DATA:

(1) diameter (inches) 2

(2) total depth (feet) 505'

(3) static water level (feet) 30' below top of ground. above

(4) casing PVC 485'  
 (material) (depth)  
2" - If telescope see back.  
 (size)

(5) screen 20' 485'  
 (length) (depth to top)  
2" #8 #6 on Bat. PVC  
 (size) (material)

(6) pump hml 8-10  
 (HP) (yield gpm)  
no  
 (type power)

(7) electric log no  
 (yes or no)  
no  
 (organization running log)


(8) how well bottom plugged PVC  
Ball Check

DRILLERS REMARKS: No Pressure  
Well Low Water.

1-15-85  
 JTY

If well telescopes please sketch and show depths.

GROUND LEVEL

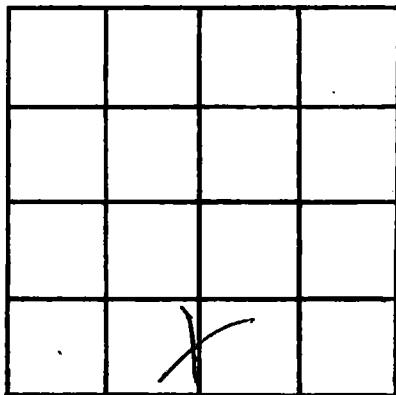

SECTION 237

Please indicate well location X.

ADDITIONAL INFORMATION

If more than one screen, show locations of each on sketch.