

**MISSISSIPPI DEPARTMENT OF NATURAL RESOURCES**  
**Bureau of Land and Water Resources**  
 Southport Mall  
 P.O. Box 10631  
 Jackson, Mississippi 39209  
**WATER WELL DRILLERS LOG**

4431

BZ  
JACKSON CO.  
10-14-84

**CODED**

10-14-84 19 84 Amigo Well Serv Jackson  
 date well completed firm name county well located

LANDOWNER: Jimmie Deabel  
Armedal ms  
 (mailing address)

description of formations encountered	from	to
top soil clay	0	20
clay	20	40
clay	40	60
sand	60	80
sand	80	100
clay	100	140
fine sand	140	145
clay	145	250
sand cone	250	255
clay	255	350
chise sand	350	375

WELL LOCATION:  
S ~~sec~~ T 4 N R 7 E  
20 miles South of Lucedale  
 (distance) (direction) (nearest town)

WELL PURPOSE:  
 (home, irrigation, municipal, industrial)


- WELL COMPLETION DATA:
- (1) diameter (inches) 2
  - (2) total depth (feet) 475
  - (3) static water level (feet) 40-50 <sup>below</sup> <sub>above</sub> top of ground.
  - (4) casing PVC 455'  
 (material) (depth)
  - no if telescope see back.  
 (size)
  - (5) screen 20 455'  
 (length) (depth to top)
  - 2" PVC  
 (size) (material)
  - (6) pump none 50-70  
 (HP) (yield gpm)
  - hand  
 (type power)
  - (7) electric log no  
 (yes or no)
  - no  
 (organization running log)
  - (8) how well bottom plugged PVC  
Ball chuff

DRILLERS REMARKS: good  
Over John

1-17-85  
ZTW

If well telescopes please sketch and show depths.

GROUND LEVEL

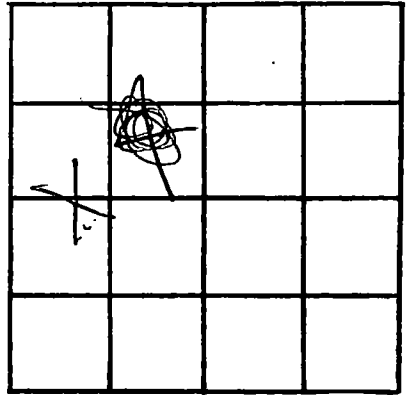

SECTION

037

Please indicate well location X.

ADDITIONAL INFORMATION

If more than one screen, show locations of each on sketch.