

MISSISSIPPI DEPARTMENT OF NATURAL RESOURCES

Bureau of Land and Water Resources

Southport Mall

P.O. Box 10631

Jackson, Mississippi 39209

WATER WELL DRILLERS LOG

CODED

Jackson
B26

2-11-86 19 Coostwaterwell Jackson
date well completed firm name county well located

LANDOWNER: Frank Maples

22528 Old Kuer Rd.
Vandeventer, M.
(mailing address)

WELL LOCATION:

sec. 28 T. 4 N. R. 7 W.
9 miles N of Vandeventer
(distance) (direction) (nearest town)

WELL PURPOSE: home
(home, irrigation, municipal, industrial)

WELL COMPLETION DATA:

- (1) diameter (inches) 4"
- (2) total depth (feet) 265 ft.
- (3) static water level (feet) 147 below top of ground.
- (4) casing PVC 240 ft (material) (depth)
4" (size) if telescope see back.
- (5) screen 20 ft 240 ft (length) (depth to top)
4" PVC (size) (material)
- (6) pump 1 1/2 HP 20 (yield gpm)
Elect (type power)
- (7) electric log NO (yes or no)

(8) how well bottom plugged
Backwash valve

DRILLERS REMARKS:

5' 4" PVC tail pipe

description of formations encountered	depth	
	from	to
Top Soil	0	1
Red Clay	1	34
Blue Clay	34	200
Gray Sand	200	215
Gray Coar. Sand	215	260
Blue Clay	260	265


CODED

RECEIVED
MAR 7 1986

Department of Natural Resources
Bureau of Land and Water Resources

If well telescopes please sketch and show depths.

GROUND LEVEL

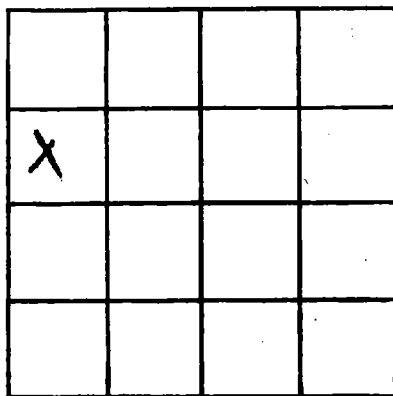

SECTION 28

Please indicate well location X.

ADDITIONAL INFORMATION

If more than one screen, show locations of each on sketch.