
······································	state W	ell Report	
County: JACKSON	Part 1		For Office Use Only:
Mississippi Department of			Aquifer:
Permit #:	Office of Land and Water Resources P.O. Box 10631		Well #: B-55
Driller: $UUUJI WUIU WUU'' $	Jackson, MS 39289-0631 (601)961-5210 (601)354-6938 (fax)		L. S. Elevation:
Date drilling completed: 8-212-00			E-log #:
State Law requires that this rep 30 days of completion of drilling	ort be prepared by the o	lriller in detail and filed w	ith the Department within
Well Owner Inform	ation		Location
Owner Name Legacy HON	nes-Gary watts	Latitude: <u>30 • 39 • 30</u>	" Longitude <u>088° 40,748</u>
Mailing Address: 3412 Hay	0	Method of Lat/Long (circle or	e): Conventional Survey,
j		USGS quad, Hand-held	GPS) Survey-grade GPS /
Gautier Ms 39553 City State Zip Code NW 1/2 Stor 1/4 Sec 34		NE 1/2 SEO 1/2 Sec 34	Jun TH S Rng R 71
Telephone No. 208 497-43	38	Distance Direction MilesMORTH_	Nearest Town of <i>PRICLEAVE</i>
	Weil D	ata	
Purpose of Well (circle one) Home Inc	lustrial Public Supply	Irrigation Fish Culture	Other:
Date well drilling started: 8-21	-		
- · · ·			
If flowing, method of flow regulation: Va	• •		• • • •
Static Water Level: <u>125</u> feet a	bove or below (circle one) la	nd surface Date measured:	0 da Ul
Method of Measurement (circle one) s	teel tape electric tape	air line other:	
100 '	190'		
Hole depth: <u>199</u> Well de	pth:	Well grouted to a depth of	feet
Hole depth: <u>1999</u> Well de Type of grout (circle one): Cement	Bentonite Mix	Well grouted to a depth of	feet
Type of grout (circle one): Cement	Bentonite Mix		
Type of grout (circle one): Cement Casing length: 184 feet Casi	Bentonite Mix ng diameter:	_inches Type of casing: _	JVC
Type of grout (circle one): Cement Casing length: 184 feet Casi Screen length: 15 feet Scree	Bentonite Mix ng diameter:	_inches Type of casing:	<u>)vC</u>
Type of grout (circle one): Cement Casing length: 184 feet Casi Screen length: 15 feet Scree Screen slot size: 0000 inches	Bentonite Mix ng diameter: ten diameter: Setting depth: From	_inches Type of casing: _inches Type of screen: feet to) V C 99feet
Type of grout (circle one): Cement Casing length: 184 feet Casi Screen length: 15 feet Scree	Bentonite Mix ng diameter: ten diameter: Setting depth: From	_inches Type of casing: _inches Type of screen: feet to	<u>)vC</u>
Type of grout (circle one): Cement Casing length: 184 feet Casi Screen length: 15 feet Scree Screen slot size: 0000 inches	Bentonite Mix ng diameter: ten diameter: Setting depth: From Gravel packed Underro	_inches Type of casing: _inches Type of screen: feet to)VC <u> VC</u> <u> 99</u> feet hole Natural Development
Type of grout (circle one): Cement Casing length: 184 feet Casi Screen length: 15 feet Scree Screen slot size: 0000 inches	Bentonite Mix ng diameter: ten diameter: Setting depth: From Gravel packed Underrow Other (describe):	_inches Type of casing: _inches Type of screen: feet to eamed Telescoped Open)VC <u> VC</u> <u> 99</u> feet hole Natural Development
Type of grout (circle one): Cement Casing length: 184 feet Casi Screen length: 15 feet Scree Screen slot size: 2000 inches Type of completion (circle all applicable):	Bentonite Mix ng diameter: ten diameter: Setting depth: From Gravel packed Underro Other (describe): feet. If tele	_inches Type of casing:) V C) V C 9 7 feet hole Natural Development een, describe on back of page
Type of grout (circle one): Cement Casing length: <u>184</u> feet Casi Screen length: <u>15</u> feet Scree Screen slot size: <u>• 000</u> inches Type of completion (circle all applicable): Top of lap pipe or reduction in casing: <u></u> Logs run (circle all applicable): No log ru Name of organization running log(s): <u>N</u>	Bentonite Mix ng diameter: ten diameter: Setting depth: From Gravel packed Underro Other (describe): feet. If tele DElectric Gamma Ray	_inches Type of casing:) V C) V C 9 9 feet hole Natural Development een, describe on back of page Other:
Type of grout (circle one): Cement Casing length: 184 feet Casi Screen length: 15 feet Scree Screen slot size: 0000 inches Type of completion (circle all applicable): Top of lap pipe or reduction in casing: Logs run (circle all applicable): No log run Name of organization running log(s): I certify that the well was drilled, constr	Bentonite Mix ng diameter: sen diameter: Setting depth: From Gravel packed Underry Other (describe): feet. If tele n) Electric Gamma Ray A ructed, and completed in ac	_inches Type of casing:	WC YC 97 feet hole Natural Development een, describe on back of page Other:
Type of grout (circle one): Cement Casing length: <u>184</u> feet Casi Screen length: <u>15</u> feet Scree Screen slot size: <u>• 000</u> inches Type of completion (circle all applicable): Top of lap pipe or reduction in casing: <u></u> Logs run (circle all applicable): No log ru Name of organization running log(s): <u>N</u>	Bentonite Mix ng diameter: sen diameter: Setting depth: From Gravel packed Underry Other (describe): feet. If tele n) Electric Gamma Ray A ructed, and completed in ac	_inches Type of casing:	WC YC 97 feet hole Natural Development een, describe on back of page Other:
Type of grout (circle one): Cement Casing length: 184 feet Casi Screen length: 15 feet Scree Screen slot size: 0000 inches Type of completion (circle all applicable): Top of lap pipe or reduction in casing: Logs run (circle all applicable): No log run Name of organization running log(s): I certify that the well was drilled, constr	Bentonite Mix ng diameter: sen diameter: Setting depth: From Gravel packed Underry Other (describe): feet. If tele n) Electric Gamma Ray A ructed, and completed in ac	_inches Type of casing:	WC YC 97 feet hole Natural Development een, describe on back of page Other:

B-55

If well telescopes please sketch below and show depths.

۰,

If more than one screen, show location of each on sketch

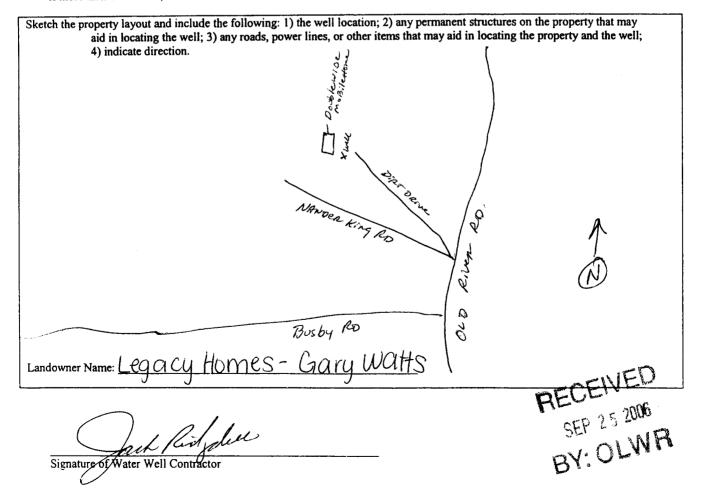

	STATE WI	ELL REPORT	
County: Jackson Permit #: Driller Cast Water Wells RV. Date completed: 8-22-06	Part 2 Pump Installer's Completion Report Mississippi Department of Environmental Quality Office of Land and Water Resources P.O. Box 10631 Jackson, MS 39289-0631 (601)961-5210 (601)354-6938 (fax)		For Office Use Only: Aquifer: Well #: <u>B-55</u> Elevation:
This report should be prepared by th	e pump installer in deta	il and filed with the Departme	ent within 30 days of the
installation of pump. Well Owner Information Owner Name: Legacy HOMS - Gary Watts Mailing Address: 3412 HWY 90 Gautiller MS 3 City State Zip Code Telephone No 208 497-4338		Well Location Latitude: <u>20'39'300</u> " Longitude: <u>088°40'748</u> Method of Lat/Long (circle one): Conventional Survey, USGS quad, Hand-held GPS Survey-grade GPS <u>NE 1/4 SW 1/4 Sec 3/4 Twn 77/5 Rng R7W</u>	
		Distance Direction Nearest Town <u>9</u> Miles Morth of Vencleave	
Ритр Туре			wer Type
Circle one			ircle one
Air Lift Jet 1	Submersible		ne Engine Natural Gas
Bucket Piston	Turbine	Electric Motor Hand	Tractor PTO
Centrifugal Rotary Other (specify): Date Pump Installed:6 Rated Pump Capacity:6	Flowing Well Gallons Per Minute	Windmill Other Horse Power Rating of Motor Setting Depth: 140 FT Number of Stages:	
Pump Test Data			asuring Water Level
Date Well Tested: <u>8-29-06</u> Static Water Level (A): <u>125</u> Feet I Pumping Water Level (B): <u>NA</u> Feet E		Air Line Electric Mea	ircle one suring Line Steel Tape
Drawdown [(B) – (A)]: NA Feet I	Below Land Surface	For flowing well, measured sh	nut in head: <u>N/A</u> feet
Test Pumping Rate:	Gallons Per Minute	Well yielded 6	GPM with a drawdown of
Duration of Pump Test (minimum 4 hours):			N/A hours of pumping
I HEREBY CERTIFY that the above statemed <u>Jack R'Hogdell 0-47</u> Print Name of Pump Installer and License No	<u> </u>	f my knowledge. ark K Signature of Pump In	staller BY: OLW

•