| State We | ell Report | | | | |
|--|--|--|--|--|--|
| Pa | ert 1 For Office Use Only: | | | | |
| Mississippi Department | of Environmental Quality Aquifer: | | | | |
| P.O. BO | ox 10631 well #: <u>1,) - (, , , , , , , , , , , , , , , , , , </u> | | | | |
| Jackson, M. | S 39289-0631 L. S. Elevation: 61-5210 | | | | |
| Date drinning completion. II | -6938 (fax) E-log #: | | | | |
| State Law requires that this report be prepared by the c 30 days of completion of drilling of the well. | driller in detail and filed with the Department within | | | | |
| Well Owner Information | Well Location | | | | |
| Owner Name_Billy Bond | Latitude: 30. 43. 121" Longitude 08. 44. 407" | | | | |
| Mailing Address: Simsmill Poncl Rd. | $\begin{array}{c} 40 & 23 \\ \text{Method of Lat/Long (circle one): Conventional Survey,} \end{array} \begin{array}{c} 40 & 32 \\ \end{array}$ | | | | |
| | USGS quad, Hand-held GPS Survey-grade GPS | | | | |
| Vancleave, MS 39565 City State Zip Code | 58 1/ NW 1/4 Sec 27 Twn T45 Rng R7W | | | | |
| Telephone No. 288219-2502 | Distance Direction Nearest Town <u>10</u> Miles <u>NORTH</u> of <u>UAwcfeare</u> | | | | |
| Well D | ata | | | | |
| Purpose of Well (circle one) (Home) Industrial Public Supply | Irrigation Fish Culture Other: | | | | |
| Date well drilling started: <u>11-20-06</u> Date well drilling completed: <u>11-21-06</u> | | | | | |
| If flowing, method of flow regulation: Valve MA Other (de: | If flowing, method of flow regulation: Valve MA Other (describe) | | | | |
| Static Water Level: <u>50</u> feet above or below circle one) la | | | | | |
| Method of Measurement (circle one) steel tape electric tape | air line other: | | | | |
| Hole depth: <u>210'</u> Well depth: <u>210'</u> Well grouted to a depth of <u>10</u> feet | | | | | |
| Type of grout (circle one): Cement Bentonite Mix | | | | | |
| Casing length: 195 feet Casing diameter: | inches Type of casing: <u>PVC</u> | | | | |
| Screen length: 15 feet Screen diameter: 2 inches Type of screen: PVC | | | | | |
| Screen slot size: 1000 inches Setting depth: From 195 feet to 210 feet | | | | | |
| Type of completion (circle all applicable): Gravel packed Underre | | | | | |
| Other (describe): | | | | | |
| Top of lap pipe or reduction in casing: N/A feet. If telescoped or more than one screen, describe on back of page | | | | | |
| Logs run (circle all applicable): No log run Electric Gamma Ray | Density Sonic Neutron Other: | | | | |
| Name of organization running log(s): N/A | | | | | |
| I certify that the well was drilled, constructed, and completed in accordance with all applicable requirements of the Mississippi Department of Environmental Quality and/or the Mississippi Department of Health regulations and state laws. | | | | | |
| Tak Di Lullouro | | | | | |
| UUCK KIOGOLII U-472 | - And Mayar RECEIVED | | | | |
| Print Name of Water Well Contractor and License No. | Signature of Water Well Contractor | | | | |

•

ʻ **x**,

BY: OLWF

If well telescopes please sketch below and show depths.

B-62


Ground Level

2

.

| Description of Formations Encountered TOP Soil White COArse Sand Blue Clay Med. to coarse sand Blue Clay Gray manum Sand | From 0 15 135 135 185 | To 15 118 135 186 20 |
|--|--------------------------------------|-------------------------------------|
| | | |
| | | |
| | | |

If more than one screen, show location of each on sketch

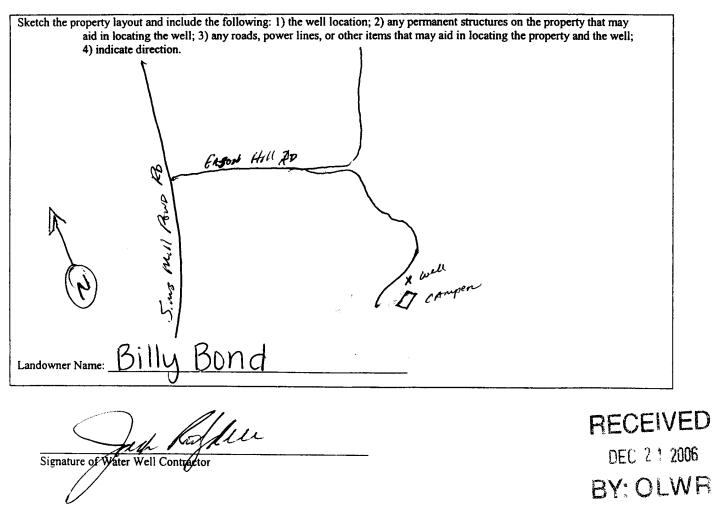

| STATE WELL REPORT | | | | |
|--|---|--|-----------------------|-----------------|
| County: JACKSON Permit #: Driller(Dast Water Well SPV Date completed: 11-21-DUP | Pump Installer? Mississippi Departmer Office of Land a P.O. I Jackson, N (601) | art 2 s Completion Report at of Environmental Quality and Water Resources Box 10631 4S 39289-0631 961-5210 4-6938 (fax) | Aquifer: Well #: B | ffice Use Only: |
| This report should be prepared by th | e pump installer in deta | il and filed with the Depa | rtment within 30 d | ays of the |
| installation of pump. Well Owner Informat | ion | | Well Location | |
| Owner Name: Billy BONd | | Latitude: 30°43' 12 | <u>}</u> Longitude: D | 88°44'407" |
| Mailing Address: Sins Mill 1 | Powers Ro | Method of Lat/Long (circ | le one): Convention | al Survey, |
| | | USGS quad, 🕻 | Hand-held GPS, Sur | vey-grade GPS |
| VAncleane, M5. City State | 39565 Zin Code | SE 1/4 NW 1/4 Sec | 27_Twn 74. | I Rng R7W |
| | | Distance Direction | on Nearest To | wn |
| Telephone No. 288) 219-25 | 02 | 10 Miles North | r of Vande | wae- |
| Ритр Туре | · · · · · · · · · · · · · · · · · · · | ······································ | Power Type | |
| Circle one | | | Circle one | |
| Air Lift Jet | Submersible | Diesel Engine Ga | soline Engine | Natural Gas |
| Bucket Piston | Turbine | Electric Motor Ha | and | Tractor PTO |
| Centrifugal Rotary | Flowing Well | | her (specify): | |
| Other (specify): | | Horse Power Rating of M | otor: | |
| Date Pump Installed: 11-22-00 | ρ | Setting Depth: 80 F7. | drop pipe | _feet |
| Rated Pump Capacity: <u>7.5</u> | Gallons Per Minute | Number of Stages: | 2 | - |
| Pump Test Data | | Method of | Measuring Water | Level |
| Date Well Tested: 1-20-00 | | \frown | Circle one | |
| Static Water Level (A): 50 Feet 1 | Below Land Surface | Air Line Electric I | Measuring Line | Steel Tape |
| Pumping Water Level (B): <u>MA</u> Feet E | Below Land Surface | Other (specify): | | |
| Drawdown [(B) - (A)]:Feet I | Below Land Surface | For flowing well, measure | ed shut in head: | IA feet |
| Test Pumping Rate: 7,5 | Gallons Per Minute | Well yielded 7,5 | GPM with a c | irawdown of |
| Duration of Pump Test (minimum 4 hours): | <u>4 1/2 hours</u> | NIA_feet afte | er NIA_ho | ours of pumping |
| I HEREBY CERTIFY that the above statemed BEN Ridgd Ell Print Name of Pump Installer and License No | 0-713P | my knowledge. Ben Riche Signature of Pum | | RECEIVE |
| | | | | BY: OLW |

• •

4

.

٠