	State Well Re	port				
County: Jackson	Part 1	-	For Office Use Only:			
Mississig	pi Department of Envi		Aquifer:			
	Office of Land and Water Resources P.O. Box 10631 Well #: <u>B-70</u>					
DrillerCOAST WATER WELLSOV.	Jackson, MS 39289		L. S. Elevation:			
Date drilling completed: <u>5-29-07</u>	(601)961-5210 (601)354-6938 (1		E-log #:			
State Law requires that this report be prepared by the driller in detail and filed with the Department within 30 days of completion of drilling of the well.						
Well Owner Information			Location			
Owner Name_Richard Terry_		<u>:30.39.44</u> 30	¹ " Longitude: <u>08° 40 · 783</u> . 47			
Mailing Address: 21437 Old RIVER F	<u>A.</u> Method	Method of Lat/Long (circle one): Conventional Survey,				
		SGS quad, Hand-held GPS, Survey-grade GPS				
Vancleave, MS 39545 City State Zip Code		Nor 1/4 Mar 1/4 Sec 34 Twin 45 Rig P. Thi				
Telephone No. () 28 8 2 6 - 39 77	Distance		Tance Direction Nearest Town <u>Miles</u> <u>Northof</u> <u>Januate Arren</u>			
	Well Data					
Purpose of Well (circle one) Industrial Public Supply Irrigation Fish Culture Other:						
Date well drilling started: $5 - 29 - 07$						
If flowing, method of flow regulation: Valve N	A Other (describe)					
Static Water Level: 135 feet above of below (circle one) land surface Date measured: 5-29-07						
Method of Measurement (circle one) steel tape electric tape air line other:						
Hole depth: <u>AAO'</u> Well depth: <u>AAO'</u> Well grouted to a depth of <u>IO</u> feet						
Type of grout (circle one): Cement Bentonite Mix						
Casing length: <u>AID</u> feet Casing diameter: <u>A</u> inches Type of casing: <u>OVC</u>						
Screen length: 10 feet Screen diameter: 2 inches Type of screen: DVC						
Screen slot size: <u>·000</u> inches Setting depth: From <u>210</u> feet to <u>220</u> feet						
Type of completion (circle all applicable): Gravel packed Underreamed Telescoped Open hole Natural Development						
Other (describe):						
Top of lap pipe or reduction in casing:	feet. If telescoped of	r more than one scre	en, describe on back of page			
Logs run (circle all applicable): No log run Electric Gamma Ray Density Sonic Neutron Other:						
Name of organization running log(s): NIA						
I certify that the well was drilled, constructed, and completed in accordance with all applicable requirements of the Mississippi						
Department of Environmental Quality and/or the Mississippi Department of Health regulations and state laws.						
Jack Ridgdell 0-472	~	Jan	Children			
Print Name of Water Well Contractor and License No		Signature of V				
JUN 28 2007						

•••

BY: OLWR


B-70

If well telescopes please sketch below and show depths.

Ground Level

 Description of Formations Encountered TOD SQII ORANGE CIAU GOUN COALSE SAND BLUE CIAU BLUE CIAU BLUE CIAU BLUE CIAU BLUE CIAU	From To 0 2 18 18 30 15 105 105 105 2010 30 0 0 0 0 0 0 0 0 0 0 0 0 0

If more than one screen, show location of each on sketch

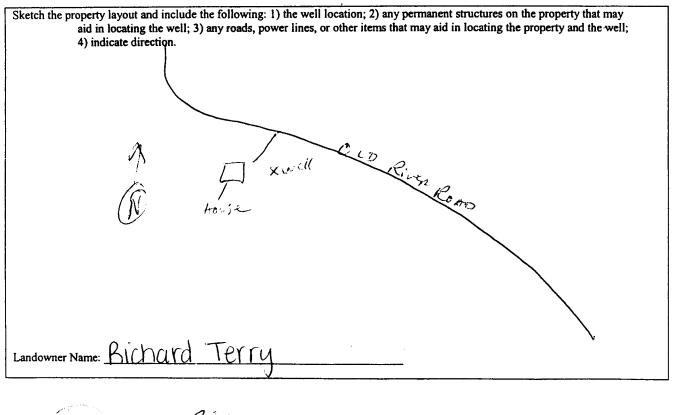

Signature of Water Well Contractor

JUN 2 8 2007 BY: OLWR

County: JOCKSDN Permit #: Driller(DAST WOLLEY WELL SRV. Date completed: 5-39-07	(601)961-5210 (601)354-6938 (fax)		For Office Use Only: Aquifer: Well #: <u>B - 70</u> Elevation:			
This report should be prepared by the pump installer in detail and filed with the Department within 30 days of the installation of pump.						
	Well Owner Information		Well Location			
	wher Name: <u>Richard</u> Terry Iailing Address: <u>A 1037 Old River Rd</u> .		Latitude: <u>30°39'499</u> "Longitude: <u>D88°40'783</u> " Method of Lat/Long (circle one): Conventional Survey, USGS quad, Hand-held GPS) Survey-grade GPS			
Vancleavems 395/e5 City State Zip Code		<u>NW 4 NW 4 Sec 34 Twn 745 Rng Row</u> Distance Direction Nearest Town				
Telephone No. (208 8016 - 3977		9 Miles NORTH of VANICLEAN				
Pump Type			wer Type			
Circle one			ircle one			
Air Lift (Jet	Submersible	Diesel Engine Gasolin	e Engine Natural Gas			
Bucket Piston	Turbine	Electric Motor Hand	Tractor PTO			
Centrifugal Rotary	Flowing Well	Windmill Other ((specify):			
Other (specify):		Horse Power Rating of Motor:	2HP			
Date Pump Installed: 5-30-0	Date Pump Installed:5-30-07		Setting Depth: 100 Ft. drop pipereet			
Rated Pump Capacity: <u>5.5</u>	Gallons Per Minute	Number of Stages:	3 ' ' '			
Pump Test Data			asuring Water Level			
Date Well Tested: 5-30-0]	E	ircle one			
Static Water Level (A): 135 Feet	Below Land Surface	Air Line Electric Meas	suring Line Steel Tape			
Pumping Water Level (B): NA Feet Below Land Surface		Other (specify):				
Drawdown [(B) – (A)]: M Feet Below Land Surface		For flowing well, measured shut in head: <u>NIA</u> feet				
Test Pumping Rate: 5.5 Gallons Per Minute		Well yielded 5.5 GPM with a drawdown of				
Duration of Pump Test (minimum 4 hours):			N A hours of pumping			
I HEREBY CERTIFY that the above statem JACK Ridgdell O Print Name of Pump Installer and License N	-472	f my knowledge. Signature of Pump Ins	JUN 2 8 2007			

ť

.

BY: OLWR