	State Well I	Report	East Office Use Asher
county Jackson	Part 1	-	For Office Use Only:
	Mississippi Department of E	vironmental Quality	Aquifer: Well #: B - 73
Permit #:		Office of Land and Water Resources P.O. Box 10631	
Driller Dast Ward Wellow	Jackson, MS 392		L. S. Elevation:
Date drilling completed: 8-8-07	(601)961-5 (601)354-6931		E-log #:
State Law requires that this report 30 days of completion of drilling of	rt be prepared by the drille	r in detail and filed w	ith the Department within
Well Owner Informati		Well	Location
Dwner Name Michael + Lindse	ey Barton Latitude: 20.39.77		7 Longitude: 088 41 . 705
Mailing Address 22551 Old Rive	er f.d. Method of Lat/Long (circle on		e): Conventional Survey, 42
		USGS quad, Hand-held	GPS Survey-grade GPS
Vancleave Ms	39565 5	1/5W 1/ Sec 28	Twn T45 Rng R7w
City State	Zip Code SF	-	
relephone No. (208) 226 - 178	S9	<u>/2</u> Miles <u>No.57</u>	of <u>VAncleur</u>
-	Well Data		
Purpose of Well (circle one) Home? Indu	strial Public Supply Irrig	ation Fish Culture	Other:
Date well drilling started:			
f flowing, method of flow regulation: Valv	•		
Static Water Level:feet abo	ve or below (circle one) land su		
Method of Measurement (circle one) stee	el tape electric tape a	ir line other:	
Hole depth: <u>ALOS FT</u> . Well dept	h: <u>268 FT</u> , We	l grouted to a depth of	(Ofeet
Type of grout (circle one): Cement (Bentonite Mix		0.10
Casing length: <u>258</u> feet Casing	g diameter: <u>2</u> inch	es Type of casing:	
Screen length: <u> </u>	n diameter:inch	es Type of screen:	puc
Screen slot size: <u>OO4</u> inches	Setting depth: From	feet to 0	168 feet
Type of completion (circle all applicable):	Gravel packed Underreamed	l Telescoped Open	hole Natural Development
	Other (describe):		······································
Top of lap pipe or reduction in casing:	A feet. If telescope	ed or more than one scr	een, describe on back of page
Logs run (circle all applicable) No log run	Electric Gamma Ray Dens	sity Sonic Neutron	Other:
Name of organization running log(s): N	JA sted, and completed in accord	ance with all applicable	requirements of the Missission
Department of Environmental Quality an	-		
	•	•	21
Tal Oil 1.11	\wedge 1/	\frown	141
Jack Ridgdell	0-472	_ Sauk	1 Kit Jun - 0472

٣

0

AUG 1 5 2007 BY: OLWR

B-73

BY: OLWR

If well telescopes please sketch below and show depths.


Ground Level

ž

	Description of Formations Encountered	From To
	TOPSAIL	1/2
	nrange, clay	17 10
	Brown Coarse Sand	10 25
	Blue clay	25 254
		574 512
	Gray medium Sana	- and the
	······································	
	······································	
1		

If more than one screen, show location of each on sketch

L

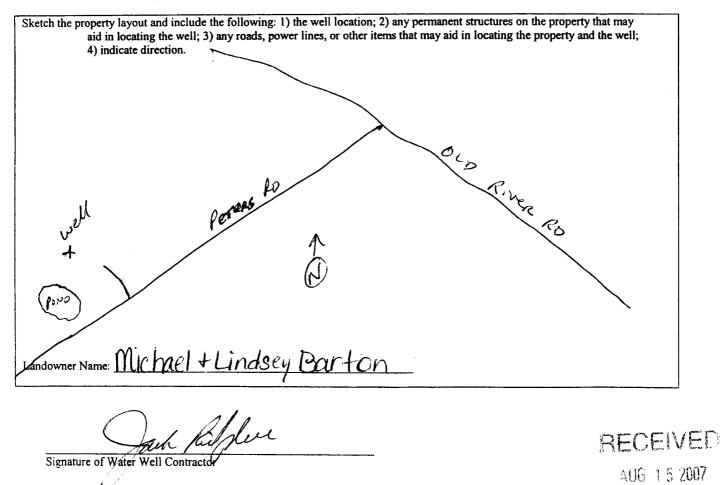

		ELL REPORT		
County: JUCKSON Permit #: Driller COASH WATCO WEI/SRV. Date completed: <u>8-8-07</u>	Pump Installer' Mississippi Departmen Office of Land P.O. Jackson, M (601	Part 2 s Completion Report at of Environmental Quality and Water Resources Box 10631 MS 39289-0631 0961-5210 64-6938 (fax)	For Office Use Only: Aquifer: Well #: <u>B-73</u> Elevation:	
This report should be prepared by the	ie pump installer in deta	il and filed with the Departme	ent within 30 days of the	
installation of pump. Well Owner Informat	ion	We	ll Location	
Owner Name: Michael + Linc	lsey Parton	Latitude; 20°39'773	Longitude: 088°41'705	
Mailing Address: 00551 010 1	River Rd.	Method of Lat/Long (circle or		
Vancleave Ms 39565 City State Zip Code		USGS quad, $\underbrace{\text{Hand-held GPS}}_{\text{Survey-grade GPS}}$ $\underbrace{SW 4}_{\text{SW}} \underbrace{SW 4}_{\text{Sec}} \underbrace{O8}_{\text{Twn}} \underbrace{T4S}_{\text{Rng}} \underbrace{R7W}_{\text{Rng}}$ Distance Direction Nearest Town		
Telephone No. <u>208</u> <u>876 - 178</u>	9	<u>912 Miles NOV.H. o</u>	F VANC/Paves	
Ритр Турс		Po	wer Type	
Circle one			ircle one	
Air Lift Jet	Submersible	Diesel Engine Gasolir	e Engine Natural Gas	
Bucket Piston	Turbine (Electric Motor Hand	Tractor PTO	
Centrifugal Rotary	Flowing Well		specify):	
Other (specify):	<u></u>	Horse Power Rating of Motor:		
Date Pump Installed: 8-18-0	1	Setting Depth: <u>140FT.</u>]	XOP pipereet	
Rated Pump Capacity:5.5	Gallons Per Minute	Number of Stages:	3	
Pump Test Data		Method of Me	asuring Water Level	
Date Well Tested: 8-18-97			rcle one	
10.0	Below Land Surface	Other (specify):	suring Line Steel Tape	
Pumping Water Level (B): <u>NA</u> Feet B	Below Land Surface		······································	
Drawdown [(B) – (A)]: Feet I	Below Land Surface	For flowing well, measured sh	ut in head: <u>NA</u> feet	
Test Pumping Rate: 5,5	Gallons Per Minute	Well yielded 5.5		
Duration of Pump Test (minimum 4 hours):	<u> </u>	<u>N/A</u> feet after	N/A hours of pumping	
I HEREBY CERTIFY that the above statem JACK Ridgdell	0-472	ah 10	iffer	
Print Name of Pump Installer and License N	o. (11 applicable)	Signature of Pump In:	staller RECEV	
			AUG 27 20	
			BY: OLV	

• ,