State W	ell Report				
County: Jackson P	art 1	For Office Use Only:			
Mississippi Departmen	t of Environmental Quality	Aquifer:			
Permit #: Office of Land a	nd Water Resources	Well #: B-80			
TO THE ACTIVITY OF THE PARTY OF	Box 10631 IS 39289-0631				
1 M 19 L ) [	961-5210	L. S. Elevation:			
(601) 35	4-6938 (fax)	E-log #:			
State Law requires that this report be prepared by the 30 days of completion of drilling of the well.					
Weil Owner Information		Location			
Owner Name ADAM Whise	Latitude: 30 ° 4/ · 183	?" Longitude <u>088</u> • 40 · 791 · <b>14</b>			
Mailing Address: 23520 Res Creek B.	Method of Lat/Long (circle or				
	USGS quad Hand-held	GPS Survey-grade GPS			
City State Zip Code	SE 1/4 NW 1/4 Sec 27	Twn 745 Rng R7 U			
City State Zip Code	5W				
Telephone No. 228 326-4282 Distance Direction Nearest Town    Distance   Direction   Nearest Town     Miles   North of   Variables   North of   Nearest Town		of Marchene			
Well I	Data				
Purpose of Well (circle one Home Industrial Public Supply	Irrigation Fish Culture	Other:			
Date well drilling started: 7-19-08 Date w		_			
If flowing, method of flow regulation: Valve Other (d					
Static Water Level:feet above of below (circle one) l					
Method of Measurement (circle one) steel tape electric tape	air line other:				
Hole depth: 165 FT. Well depth: 165 FT.	Well grouted to a depth of	/Ofeet			
Type of grout (circle one): Cement Bentonite Mix					
Casing length: 155 feet Casing diameter: 26	inches Type of casing:	PUC			
Screen length: 10 feet Screen diameter: 3" inches Type of screen: PUC					
Screen slot size: roo6 inches Setting depth: From 155 feet to 165 feet					
Type of completion (circle all applicable): Gravel packed Underreamed Telescoped Open hole Natural Development					
1					
Top of lap pipe or reduction in casing:feet. If tel	escoped or more than one scre	en, describe on back of page			
Logs run (circle all applicable): No log run Electric Gamma Ray	Density Sonic Neutron	Other:			
Name of organization running log(s):					
I certify that the well was drilled, constructed, and completed in a					
Department of Environmental Quality and/or the Mississippi Dep	partment of Health regulations	s and state laws.			
JACK RID 6Dell 0-472	Jan	Eflue			
Print Name of Water Well Contractor and License No.	Signature of	Water Well Contractor			
		TCUEIVEL			

AUG 2 0 2008


BY: OLWR

If well telescopes please sketch below and show depths.

Ground Level		
	ľ	

Description of Formations Encountered	From	To
700501	0	2
OrangeClay	a	IX
White Coarse Sand	18	88
Blue Clay.	88	135
White Coarde Sand Blue clay Gray Medium Sand	135	165
		$ldsymbol{ld}}}}}}}}}$
		$ldsymbol{ldsymbol{\sqcup}}$
	L	
	<u> </u>	
	<u> </u>	
	ļ	
	Ļ—	
	<u> </u>	<b></b>
		L
		igsquare
	<u> </u>	
	<u> </u>	$oxed{oxed}$
		$oxed{oxed}$

If more than one screen, show location of each on sketch

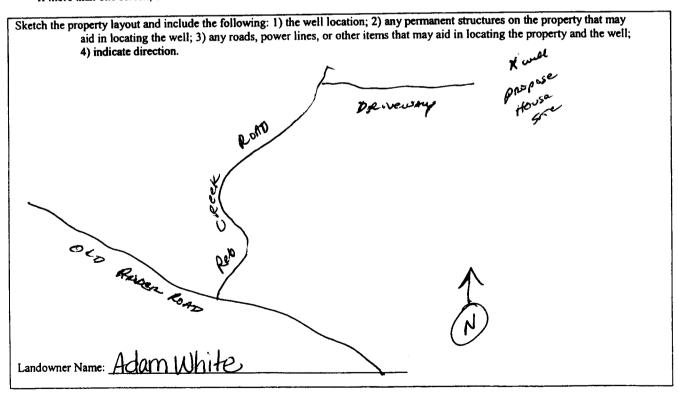

Signature of Water Well Contractor

RECEIVED

AUG 2 0 2008

BY: OLWR

	STATE WI	ELL REPORT	
	P	art 2	For Office Use Only:
County: Jacks on	Pump Installer's	s Completion Report	a or orner ose only.
	Mississippi Departmer	nt of Environmental Quality	Aquifer:
Permit#:	Office of Land	and Water Resources	0 60
Permit #:	P.O. ]	Box 10631 MS 39289-0631	Well #:
Driller: O A A		) 961-5210	
Date completed: 7-19-08		54-6938 (fax)	Elevation:
		` '	
This report should be prepared by th	e pump installer in deta	iil and filed with the Departme	ent within 30 days of the
installation of pump.			Location
Well Owner Informat	thon .		•
Owner Name: Avan Whia	<u>e</u>	Latitude: 36 41 - 183	Longitude: 088 - 40' 791
Mailing Address: 23520 Reg	Creek Ro	Method of Lat/Long (circle on	ne): Conventional Survey,
		USGS quad, Hand	-held GPS Survey-grade GPS
Vancleave 1	Us. 3956 5 Zip Code	SE 1/2 NW 1/4 Sec_ 2	2 Twn T45 Rng R7W
City State	Zip Code	Distance Direction	Nearest Town
Telephone No. 228) 816 - 42	992_	10 Miles MORTU o	1 Vancteau
Telephone 140.	<b>7</b>		
Pump Type			wer Type
Circle one		C	ircle one
Air Lift Jet	Submersible	Diesel Engine Gasolir	ne Engine Natural Gas
Bucket Piston	Turbine (	Electric Motor Hand	Tractor PTO
Centrifugal Rotary	Flowing Well	Windmill Other	(specify):
Other (specify):		Horse Power Rating of Motor	:
Date Pump Installed: 7-23-8	8	Setting Depth: 60	Dery film feet
Rated Pump Capacity: 8.5	Gallons Per Minute	Number of Stages:	2
Down Tast Date		Method of Ma	asuring Water Level
Pump Test Data		1	ircle one
Date Well Tested: 7-23-88			
		Air Line Electric Mea	suring Line Steel Tape
Static Water Level (A): 35 Feet	Below Land Surface	Other (specify):	
Pumping Water Level (B): NA Feet	Below Land Surface		
Drawdown [(B) – (A)]:Feet	Below Land Surface	For flowing well, measured sh	ı
Test Pumping Rate:	Gallons Per Minute	Well yielded 25	
Duration of Pump Test (minimum 4 hours):	hours	feet after_	hours of pumping
			_
I HEREBY CERTIFY that the above statem		of my knowledge.	//
JACK RIDEDULL O.	472	Ja 1 Kil	dul
Print Name of Pump Installer and License N	<del></del>	Signature of Pump in	staller DEOEN'E
That Name of Pulip Historic and License N	io. (ii applicable)	Ogginature of 1 mithali	staller RECEIVE

AUG 2 0 2008

BY: OLWR