

State Well Report

Part 1

Mississippi Department of Environmental Quality
Office of Land and Water Resources
P.O. Box 10631
Jackson, MS 39289-0631
(601) 961-5210
(601) 354-6938 (fax)

For Office Use Only:

Aquifer: _____
Well #: B-83
L. S. Elevation: _____
E-log #: _____

County: Jackson
Permit #: _____
Driller: Coast Water Wells sv.
Date drilling completed: 3/5/09

State Law requires that this report be prepared by the driller in detail and filed with the Department within 30 days of completion of drilling of the well.

Well Owner Information	Well Location
Owner Name: <u>Ronald Gregory</u>	Latitude: <u>30° 29' 67.2"</u> Longitude: <u>088° 40' 94.0"</u>
Mailing Address: <u>22001 Old River Rd.</u>	Method of Lat/Long (circle one): Conventional Survey,
<u>Vancleave, MS 39565</u>	USGS quad, <u>Hand-held GPS</u> Survey-grade GPS
City State Zip Code	<u>NW 1/4 NW 1/4 Sec 34 Twn T45 Rng R7 W</u>
Telephone No. <u>(601) 826-4938</u>	Distance <u>7.34</u> Miles Direction <u>North</u> of Nearest Town <u>Vancleave</u>

Well Data

Purpose of Well (circle one) Home Industrial Public Supply Irrigation Fish Culture Other: _____

Date well drilling started: 3/4/09 Date well drilling completed: 3/5/09

If flowing, method of flow regulation: Valve N/A Other (describe) _____

Static Water Level: 130 feet above or below (circle one) land surface Date measured: 3/5/09

Method of Measurement (circle one) steel tape electric tape air line other: _____

Hole depth: 212 FT Well depth: 212 FT Well grouted to a depth of 10 feet

Type of grout (circle one): Cement Bentonite Mix

Casing length: 202 feet Casing diameter: 2 inches Type of casing: PVC

Screen length: 10 feet Screen diameter: 2 inches Type of screen: PVC

Screen slot size: .006 inches Setting depth: From 202 feet to 212 feet

Type of completion (circle all applicable): Gravel packed Underreamed Telescoped Open hole Natural Development

Other (describe): _____

Top of lap pipe or reduction in casing: N/A feet. If telescoped or more than one screen, describe on back of page

Logs run (circle all applicable): No log run Electric Gamma Ray Density Sonic Neutron Other: _____

Name of organization running log(s): N/A

I certify that the well was drilled, constructed, and completed in accordance with all applicable requirements of the Mississippi Department of Environmental Quality and/or the Mississippi Department of Health regulations and state laws.

Jack Ridgdell 0-472
Print Name of Water Well Contractor and License No.


Jack Ridgdell
Signature of Water Well Contractor

RECEIVED

MAR 11 2009
BY: OLWR

If well telescopes please sketch below and show depths.


Ground Level

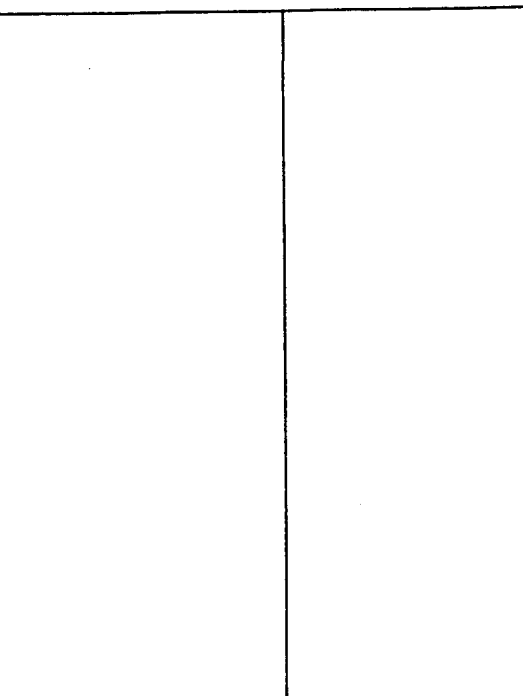

Description of Formations Encountered	From	To
TOPSOIL	0	2
Orange clay	2	24
Blue clay	24	60
Brown and white clay	60	89
Orange coarse sand	89	101
Gray coarse sand	101	193
Gray coarse sand	193	212

If more than one screen, show location of each on sketch

Sketch the property layout and include the following: 1) the well location; 2) any permanent structures on the property that may aid in locating the well; 3) any roads, power lines, or other items that may aid in locating the property and the well; 4) indicate direction.

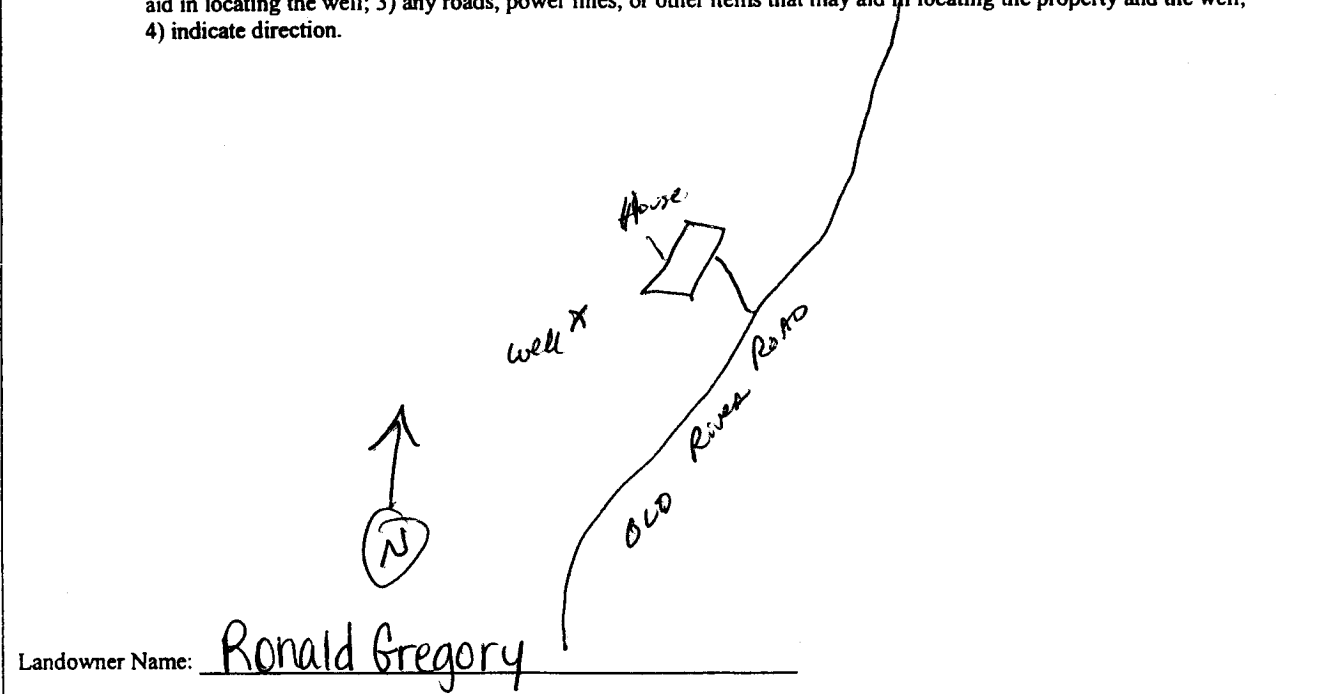

Landowner Name: Ronald Gregory

John Redpelt
Signature of Water Well Contractor

RECEIVED
MAR 11 2009
BY: OLWR

STATE WELL REPORT

Part 2

Pump Installer's Completion Report
 Mississippi Department of Environmental Quality
 Office of Land and Water Resources
 P.O. Box 10631
 Jackson, MS 39289-0631
 (601) 961-5210
 (601) 354-6938 (fax)

For Office Use Only:

Aquifer: _____

Well #: B-83

Elevation: _____

County: Jackson

Permit #: _____

Driller: Coastwater Wellsrv.

Date completed: 3/5/09

This report should be prepared by the pump installer in detail and filed with the Department within 30 days of the installation of pump.

Well Owner Information	Well Location
Owner Name: <u>Ronald Gregory</u>	Latitude: <u>30°29'672"</u> Longitude: <u>088°40'940"</u>
Mailing Address: <u>22001 Old River Rd.</u>	Method of Lat/Long (circle one): Conventional Survey,
<u>Vanclave, MS 39565</u>	USGS quad, <u>(Hand-held GPS)</u> Survey-grade GPS
City State Zip Code	<u>NW 1/4 NW 1/4 Sec 34 Twn T45 Rng R7W</u>
Telephone No. <u>228 826-4938</u>	Distance Direction Nearest Town
	<u>7 3/4</u> Miles <u>NORTH of</u> <u>Vanclave</u>

Pump Type Circle one	Power Type Circle one
Air Lift <input checked="" type="radio"/> Jet Submersible	Diesel Engine Gasoline Engine Natural Gas
Bucket Piston Turbine	<input checked="" type="radio"/> Electric Motor Hand Tractor PTO
Centrifugal Rotary Flowing Well	Windmill Other (specify): _____
Other (specify): _____	Horse Power Rating of Motor: <u>2HP</u>
Date Pump Installed: <u>3/5/09</u>	Setting Depth: <u>140 Ft. Drop pipe</u> feet
Rated Pump Capacity: <u>5.5</u> Gallons Per Minute	Number of Stages: <u>3</u>

Pump Test Data	Method of Measuring Water Level Circle one
Date Well Tested: <u>3/5/09</u>	<input checked="" type="radio"/> Air Line Electric Measuring Line Steel Tape
Static Water Level (A): <u>130</u> Feet Below Land Surface	Other (specify): _____
Pumping Water Level (B): <u>N/A</u> Feet Below Land Surface	For flowing well, measured shut in head: <u>N/A</u> feet
Drawdown [(B) - (A)]: <u>N/A</u> Feet Below Land Surface	Well yielded <u>10</u> GPM with a drawdown of
Test Pumping Rate: <u>5.5</u> Gallons Per Minute	<u>N/A</u> feet after <u>N/A</u> hours of pumping
Duration of Pump Test (minimum 4 hours): <u>5</u> hours	

I HEREBY CERTIFY that the above statements are true to the best of my knowledge.

Jack Kidgdell 0-472
 Print Name of Pump Installer and License No. (if applicable)

Jack Kidgdell
 Signature of Pump Installer

RECEIVED

MAR 11 2009

BY: OLWR