

Jackson  
 B2000  
 6-7-75

MISSISSIPPI  
 BOARD OF WATER COMMISSIONERS  
 416 North State Street  
 Jackson, Mississippi 39201


WATER WELL DRILLERS LOG

June 7 1975 Cobble Water Sep. Jackson  
 date well completed firm name county well located

LANDOWNER: <u>Donald</u>	description of formations encountered	from	to
<u>Crowley</u>			
<u>Cedar Creek</u> (mailing address)	<u>sand</u> <u>clay</u> <u>sand</u>	<u>0</u>	<u>52</u> <u>133</u> <u>172</u>
<b>WELL LOCATION:</b>			
sec <u>12</u> T <u>4</u> N R <u>7</u> E <u>13Q</u> <u>18</u> miles <u>South</u> of <u>Lucedale</u> (distance) (direction) (nearest town)			
<b>WELL PURPOSE:</b> <u>Camp</u> (home, irrigation, municipal, industrial)			
<b>WELL COMPLETION DATA:</b>			
(1) diameter (inches) <u>2</u> "			
(2) total depth (feet) <u>175</u>			
(3) static water level (feet) <u>2</u> <u>below</u> <u>above</u> top of ground.			
(4) casing <u>plast 170</u> (material) (depth)			
(size) if telescope see back.			
(5) screen <u>5</u> <u>170</u> (length) (depth to top)			
<u>2</u> <u>plast</u> (size) (material)			
(6) pump _____ (HP) _____ (yield gpm)			
(type power)			
(7) electric log <u>no</u> (yes or no)			
(organization running log)			
(8) how well bottom plugged <u>DP Valve</u>			
<b>DRILLERS REMARKS:</b> <u>Permy</u>			
<u>installed by</u> <u>owner</u>			

If well telescopes please sketch and show depths.

GROUND LEVEL

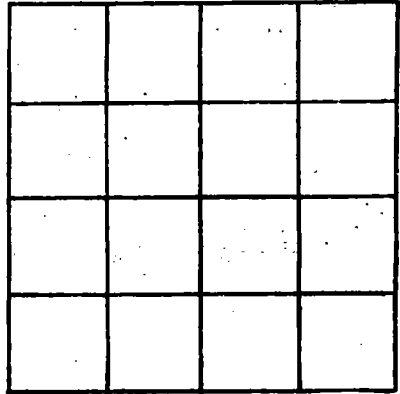

SECTION \_\_\_\_\_

Please indicate well location X.

ADDITIONAL INFORMATION

If more than one screen,  
show locations of each on sketch.