

Jackson
 B 7001
 6-23-75

MISSISSIPPI
 BOARD OF WATER COMMISSIONERS
 416 North State Street
 Jackson, Mississippi 39201

WATER WELL DRILLERS LOG


June 23 1975 Charlotte Water Sup. Jackson
 date well completed firm name county well located

LANDOWNER: <u>Vernon Broome</u> <u>Cedar Creek</u> (mailing address)	description of formations encountered	from	to
	<u>sand</u>	<u>0</u>	<u>50</u>
	<u>Clay</u>	<u>50</u>	<u>100</u>
	<u>sand</u>	<u>177</u>	<u>180</u>
WELL LOCATION: sec. <u>12</u> T. <u>4</u> N. R. <u>7</u> E. <u>132</u> <u>14</u> miles <u>South</u> of <u>Snodgrass</u> (distance) (direction) (nearest town)			
WELL PURPOSE: <u>Drinking</u> (home, irrigation, municipal, industrial)			
WELL COMPLETION DATA:			
(1) diameter (inches) <u>2</u>			
(2) total depth (feet) <u>182</u>			
(3) static water level (feet) <u>75</u> below top of ground. <u>above</u> (plate)			
(4) casing <u>Plat 177</u> (material) (depth)			
(size) If telescope see back.			
(5) screen <u>5</u> <u>177</u> (length) (depth to top)			
<u>2</u> <u>Plat</u> (size) (material)			
(6) pump _____ (HP) _____ (yield gpm)			
(type power)			
(7) electric log <u>no</u> (yes or no)			
(organization running log)			
(8) how well bottom plugged <u>BP Valve</u>			
DRILLERS REMARKS: <u>Pump installed by owner</u>			

INDEX
 12-12
 12
 OCT 31 1975
 MISS. Bd. OF WATER COMM

If well telescopes please sketch and show depths.

GROUND LEVEL

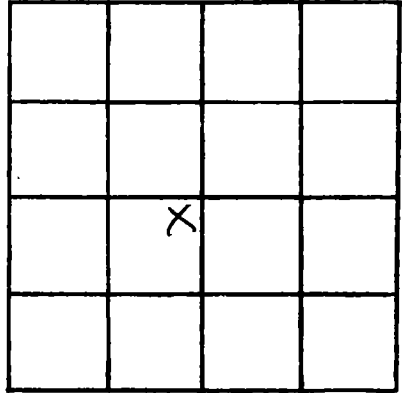

SECTION 12

Please indicate well location X.

ADDITIONAL INFORMATION

If more than one screen,
show locations of each on sketch.