

But
JACKSON
B 2005
9-24-81

MISSISSIPPI DEPARTMENT OF NATURAL RESOURCES

Bureau of Land and Water Resources

Southport Mall

P.O. Box 10631

Jackson, Mississippi 39209

WATER WELL DRILLERS LOG

9-24-81 19 Coast Water Well Serv. Inc. Jackson
 date well completed firm name county well located

LANDOWNER: Curlio Wells

824-24th St.
Greenville, Miss.
 (mailing address) 39501

WELL LOCATION:

sec. 13 T-4 N R-7 W
6 miles NW of WADE
 (distance) (direction) (nearest town)

WELL PURPOSE: Home
 (home, irrigation, municipal, industrial)

WELL COMPLETION DATA:

- (1) diameter (inches) 2"
- (2) total depth (feet) 178'
- (3) static water level (feet) flow 109' below
 top of ground.
- (4) casing PVC 168'
 (material) (depth)
- 2"
 (size) if telescope see back.
- (5) screen 10' 168'
 (length) (depth to top)
- 2" PVC
 (size) (material)
- (6) pump — —
 (HP) (yield gpm)
- (type power)
- (7) electric log No
 (yes or no)
- (organization running log)

(8) how well bottom plugged
Back Wash Water

DRILLERS REMARKS:

description of formations encountered	from	to
<u>Top soil</u>	<u>0'</u>	<u>1'</u>
<u>gray clay</u>	<u>1'</u>	<u>17'</u>
<u>gray coarse sand & gravel</u>	<u>17'</u>	<u>50'</u>
<u>Blue clay</u>	<u>50'</u>	<u>161'</u>
<u>gray coarse sand</u>	<u>161'</u>	<u>178'</u>


DEPT. OF NATURAL RESOURCES
 BUREAU OF LAND & WATER RESOURCES

OCT 19 1981

RECEIVED

If well telescopes please sketch and show depths.

GROUND LEVEL

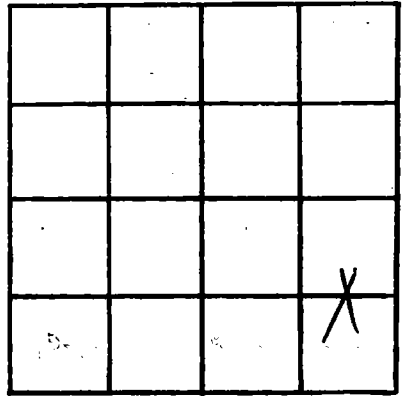

SECTION 13

Please indicate well location X.

ADDITIONAL INFORMATION

If more than one screen, show locations of each on sketch.