

MISSISSIPPI DEPARTMENT OF NATURAL RESOURCES

Bureau of Land and Water Resources

Southport Mall

P.O. Box 10631

Jackson, Mississippi 39209

WATER WELL DRILLERS LOG

Jackson  
B 7006

12-10-82 date well completed  
Coast Water Well Sw. Jackson firm name  
Jackson county well located

LANDOWNER: Edward J. Johnson

No 2-Box 217A.  
Ocean Springs Miss (mailing address) 39564

WELL LOCATION:  
sec 28 T 4 N R 7 S W  
10 miles N of VANCELENE (distance) (direction) (nearest town)

WELL PURPOSE: Home (home, irrigation, municipal, industrial)

WELL COMPLETION DATA:

- (1) diameter (inches) 2"
- (2) total depth (feet) 600'
- (3) static water level (feet) 23' below top of ground.
- (4) casing PVC, 507' 517' (material) (depth)
- 2" (size) if telescope see back.
- (5) screen 10' 507' (length) (depth to top)
- 2" PVC (size) (material)
- (6) pump 2 h.p. 8 (HP) (yield gpm)
- Elec. (type power)
- (7) electric log No. (yes or no)
- (organization running log)

description of formations encountered

description of formations encountered	from	to
Top soil	0	2'
Red. Coarse sand	2'	18'
White Clay	18'	50'
Purple Clay	50'	89'
Blue Clay	89'	252'
Strat. of sand	252'	256'
Blue Clay & Clay shale	256'	289'
Blue Clay	289'	330'
Rock	330'	333'
Blue Clay	333'	430'
Blue Clay & Clay shale	430'	585'
Gray Coarse sand	585'	600'

(8) how well bottom plugged Back wash valve

DRILLERS REMARKS:


DEPT. OF NATURAL RESOURCES  
BUREAU OF LAND & WATER RESOURCES

JAN 11 1983

RECEIVED

If well telescopes please sketch and show depths.

GROUND LEVEL

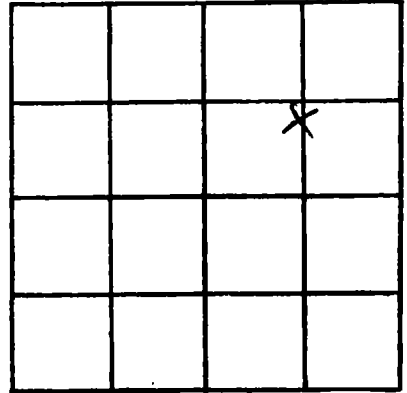

SECTION 28

Please indicate well location X.

ADDITIONAL INFORMATION

Lined area for additional information.

If more than one screen, show locations of each on sketch.