

MISSISSIPPI DEPARTMENT OF NATURAL RESOURCES

Bureau of Land and Water Resources

Southport Mall

P.O. Box 10631

Jackson, Mississippi 39209

WATER WELL DRILLERS LOG

JACKSON  
B 2007

5-30-84 19 Coast Water Well Sew. Jackson  
date well completed firm name county well located

LANDOWNER Papa Grocery  
 Hwy 90  
 Pascagoula Miss  
(mailing address) 39567

description of formations encountered	from	to
<u>Chalk (Clay) Red</u>	<u>0</u>	<u>20'</u>
<u>Sand &amp; Gravel</u>	<u>20'</u>	<u>47'</u>
<u>Chalk (Clay) (Blue)</u>	<u>47'</u>	<u>152'</u>
<u>Sand (Gray Coarse)</u>	<u>152'</u>	<u>205'</u>

WELL LOCATION:  
sec. 38 T. 4 R. 7  
6 1/2 miles NW of WADE  
(distance) (direction) (nearest town)

WELL PURPOSE: Home  
(home, irrigation, municipal, industrial)

- WELL COMPLETION DATA:
- (1) diameter (inches) 2"
  - (2) total depth (feet) 205'
  - (3) static water level (feet) Flow below top of ground.
  - (4) casing PVC, 195'  
(material) (depth)  
2" If telescope see back.  
(size)
  - (5) screen 10', 195'  
(length) (depth to top)  
2" PVC  
(size) (material)
  - (6) pump 1/2 hp, 10  
(HP) (yield gpm)  
Elus  
(type power)
  - (7) electric log No  
(yes or no)  
\_\_\_\_\_  
(organization running log)

(8) How well bottom plugged:  
Back Wash Valve


DRILLERS REMARKS:

DEPT. OF NATURAL RESOURCES  
BUREAU OF LAND & WATER RESOURCES

JUL 10 1984  
RECEIVED

If well telescopes please sketch and show depths.

GROUND LEVEL

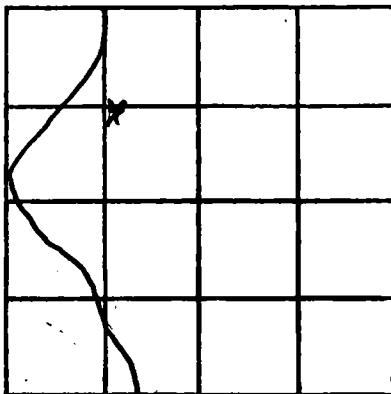

SECTION 38

Please indicate well location X.

ADDITIONAL INFORMATION

If more than one screen, show locations of each on sketch.