

MISSISSIPPI DEPARTMENT OF NATURAL RESOURCES
Bureau of Land and Water Resources

P.O. Box 10631

Jackson, Mississippi 39209

WATER WELL DRILLERS LOG

COUNTY WELL LOCATED Jackson	
WELL NUMBER B 2009	CODED
DATE WELL COMPLETED 3/24/87	

PERMIT NUMBER Frytoyle Well
NAME OF DRILLING FIRM RT 8, Box 3
Lucedale, MS

NAME & MAILING ADDRESS OF LANDOWNER Ron Jenkins			
P.O. Box 5254			
Vandover MS.			
WELL LOCATION: SEC	TOWNSHIP	RANGE	
5	28	T4 S R 7 W	
DISTANCE	DIRECTION	NEAREST TOWN	
10 Miles	North	Vandover	
OTHER LANDMARK on old River Road			
WELL PURPOSE (Home, Irrigation, Municipal, Industrial, Fish Pond, etc.)			

PUMP DATA		
PUMP TYPE (Circle One): Submersible, Turbine, Jet Flowing Well, Other (Describe) _____		
POWER TYPE (Circle One): Electric Tractor, Diesel, Gasoline, Butane, Other (Describe) _____		
Pump Capacity (GPM) 0-20	No. of Stages 3	Setting Depth 150' FT.
PUMP TEST		
Well yielded 8 GPM with a drawdown of 20' ft. after 4 hours of pumping		

WELL DATA		
Well Depth 610'	Casing Diameter (In.) 2"	Casing Length (Ft.) 600'
Type of Casing PVC	Hole Depth 735'	Depth to Static Water Level 129'
TYPE OF COMPLETION: (Circle One or More): Gravel Packed, Underreamed, Telescoped, Natural Development, Open Hole, Other (Describe) _____		
Top of Lap Pipe or Reduction in Casing		
FEET		
IF TELESCOPED OR MORE THAN ONE SCREEN: USE BACK PAGE		

LOG DATA	
TYPE OF LOG RUN (Circle One): No Log Run, Electric, Gamma Ray, Density, Sonic, Neutron, Other (Describe) _____	
Name of Organization Running Log	

SCREEN DATA		
Diameter - Inches 2"	Length - Feet 10'	Slot Size - Inches #6
Screen Type SS. - #6 Johnson Wrapped	Depth to Bottom - Feet 610'	

GEOLOGIC DATA (Office Use Only)			
Surface Elev.	Geologic Unit	Unit Thickness	Depth to Top
Subs. SWL	Date	Analysis	Aquifer Test

Driller's Remarks

RECEIVED

DESCRIPTION OF FORMATIONS ENCOUNTERED	FROM	TO	FORMATION (Continued)	FROM	TO
Top Soil	0	5			
Clay	5	50			
Scrubby Clay	50	60			
Hard Clay	60	150			
red Sand	150	170			
Hard Clay Fine Sand	170	598			
Fine Sand	598	612			
Screens set at	(600-610)				
Set	610	640			
Very Fine Sand	640	680			


JUL 23 1987

Department of Natural Resources
Bureau of Land & Water Resources

IF MORE SPACE IS NEEDED, USE BACK

If well telescopes please sketch and show depths.

GROUND LEVEL

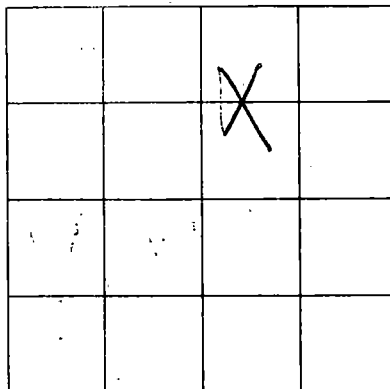

SECTION 28

Please indicate well location X.

ADDITIONAL INFORMATION

If more than one screen, show location of each on sketch.