

*add loc pump pump*  
**MISSISSIPPI DEPARTMENT OF NATURAL RESOURCES**  
 Bureau of Land and Water Resources

P.O. Box 10631  
 Jackson, Mississippi 39209  
**WATER WELL DRILLERS LOG**

COUNTY WELL LOCATED <b>Jackson</b>	
WELL NUMBER <b>B 7002</b>	CODED
DATE WELL COMPLETED <b>3-16-88</b>	

PERMIT NUMBER
NAME OF DRILLING FIRM <b>Coast Water Well Service</b>

NAME & MAILING ADDRESS OF LANDOWNER <b>M+D Construction</b>			
<b>4301 Mill Ave</b>			
<b>MOSS POINT MS.</b>			
WELL LOCATION:	SEC	TOWNSHIP	RANGE
	<b>12</b>	<b>4</b>	<b>7</b>
DISTANCE	DIRECTION	NEAREST TOWN	
<b>6</b> Miles	<b>NW</b>	<b>WADE</b>	
OTHER LANDMARK			
WELL PURPOSE: Home, Irrigation, Municipal, Industrial, Fish Pond, etc. <b>home</b>			

<b>PUMP DATA</b>		
PUMP TYPE (Circle One): Submersible, Turbine, Jet, Flowing Well, Other (Describe)		
POWER TYPE (Circle One): Electric, Tractor, Diesel, Gasoline, Butane, Other (Describe)		
Pump Capacity (GPM)	No. of Stages	Setting Depth  <b>FT.</b>
PUMP TEST		
Well yielded _____ GPM with a drawdown of _____ ft. after _____ hours of pumping		

<b>WELL DATA</b>		
Well Depth <b>330</b>	Casing Diameter (In.) <b>2"</b>	Casing Length (Ft.) <b>315'</b>
Type of Casing <b>PVC</b>	Hole Depth <b>330'</b>	Depth to Static Water Level <b>Ground Level</b>
TYPE OF COMPLETION: (Circle One or More): Gravel Packed, Underreamed, Telescoped, Natural Development, Open Hole, Other		
Top of Lap Pipe or Reduction in Casing <b>FEET</b> IF TELESCOPED OR MORE THAN ONE SCREEN: USE BACK PAGE		

<b>LOG DATA</b>	
TYPE OF LOG RUN (Circle One): Electric, Gamma Ray, Density, Sonic, Neutron, Other (Describe) <b>No Log Run</b>	
Name of Organization Running Log	

<b>SCREEN DATA</b>		
Diameter - Inches <b>2"</b>	Length - Feet <b>10'</b>	Slot Size - Inches <b>.008</b>
Screen Type <b>PVC</b>	Depth to Bottom - Feet <b>325'</b>	

<b>GEOLOGIC DATA (Office Use Only)</b>			
Surface Elev.	Geologic Unit	Unit Thickness	Depth to Top
Subs. SWL	Date	Analysis	Aquifer Test


Driller's Remarks

DESCRIPTION OF FORMATIONS ENCOUNTERED	FROM	TO
White Coastal Sand	0	30
Blue Clay	30	55
Red Coarse Sand & Gravel	55	110
Blue Clay	110	299
Gray Coastal Sand	299	325
Blue Clay	325	330

<b>RECEIVED</b>		
<b>MAY 24 1988</b>		
Department of Natural Resources Bureau of Land & Water Resources		
FORMATIONS CONTINUED	FROM	TO
IF MORE SPACE IS NEEDED, USE BACK		

If well telescopes please sketch and show depths.

GROUND LEVEL

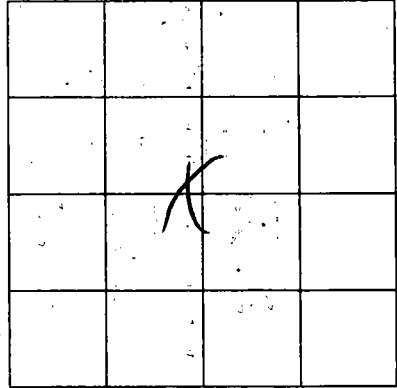

SECTION 12

Please indicate well location X.

ADDITIONAL INFORMATION

If more than one screen,  
show location of each on sketch.