

MISSISSIPPI DEPARTMENT OF ENVIRONMENTAL QUALITY

Office of Land and Water Resources

P. O. Box 10631
Jackson, MS 39289-0631
WATER WELL DRILLERS LOG

COUNTY WELL LOCATED
Jackson

WELL NUMBER 52020 CODED

DATE WELL COMPLETED
11-14-95
11-14-95

PERMIT NUMBER
0408

NAME OF DRILLING FIRM
Forrestal Well Ser.
1659 Duffin Rd
Sucitee Ms 39152

NAME & MAILING ADDRESS OF LANDOWNER
~~Bill Crimm~~
Bill Crimm
39567
16529 Old Kelly Rd Vardalems

WELL LOCATION SEC TOWNSHIP RANGE
Vardalems 28 T40 N R7 E

DISTANCE DIRECTION NEAREST TOWN
3 Miles North of Vardalems

OTHER LANDMARK
on old Kelly rd

WELL PURPOSE Home Irrigation, Municipal, Industrial, Fish Pond, etc.
the

PUMP DATA

PUMP TYPE (Circle One):
Submersible, Turbine, Flowing Well,
Other (Describe) _____

POWER TYPE (Circle One):
 Electric, Tractor, Diesel, Gasoline, Butane,
Other (Describe) 1 H/P _____

Pump Capacity (GPM) No. of Stages Setting Depth
10 2 80 FT.

PUMP TEST

Well yielded 10 GPM with
a drawdown of 5 ft.
after 1 1/2 hours of pumping

WELL DATA

Well Depth Casing Diameter (In) Casing Length (Ft)
100' 2" 90

Type of Casing Hole Depth Depth to Static Water Level
PVC 100' 60'

LOG DATA

TYPE OF LOG RUN (Circle One): No Log Run,
Electric, Gamma Ray, Density, Sonic, Neutron,
Other (Describe) _____

Name of Organization Running Log

TYPE OF COMPLETION: (Circle One or More):
Gravel Packed, Underreamed, Telescoped,
Natural Development, Open Hole, Other
(Describe) as List

WELL GROUTED TO A DEPTH OF 20 FEET
Type Grout (circle one): Cement, Bentonite, or Mix

GEOLOGIC DATA (Office Use Only)

Surface Elev. _____ Depth to Top _____

Subs. SWL _____ Analysis _____

Driller's Remarks

SCREEN DATA

Diameter - Inches Length - Feet Slot Size - Inches
2" 10' #8

Screen Type Depth to Bottom - Feet
PVC Wrapped 100'

JAN 02 1995

Top of Lap Pipe or Screen _____ FEET


IF MORE THAN ONE SCREEN, USE BACK PAGE

DESCRIPTION OF FORMATIONS ENCOUNTERED	FROM	TO	FORMATIONS (Continued)	FROM	TO
<u>top soil</u>	<u>0</u>	<u>5</u>			
<u>Clay</u>	<u>5</u>	<u>20</u>			
<u>Sand</u>	<u>20</u>	<u>40</u>			
<u>Clay</u>	<u>40</u>	<u>60</u>			
<u>Sand</u>	<u>60</u>	<u>80</u>			
<u>Sand</u>	<u>80</u>	<u>100</u>			

IF MORE SPACE IS NEEDED, USE BACK

If well telescopes please sketch and show depths.

GROUND LEVEL

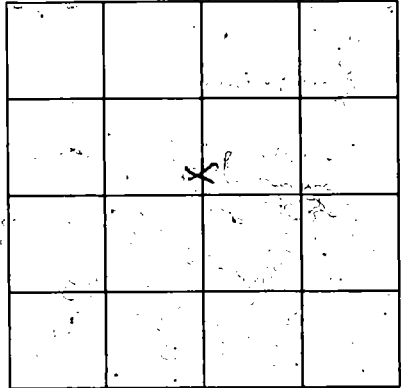

SECTION 28

Please indicate well location X.

ADDITIONAL INFORMATION

If more than one screen,
show location of each on sketch.