

MISSISSIPPI DEPARTMENT OF ENVIRONMENTAL QUALITY

Office of Land and Water Resources

P. O. Box 10631

Jackson, MS 39289-0631

WATER WELL DRILLERS LOG

COUNTY WELL LOCATED  
**Jackson**

WELL NUMBER CODED  
**B 2025**

DATE WELL COMPLETED  
**5-9-97**

PERMIT NUMBER

NAME OF DRILLING FIRM  
**Coast Water Well Service**

NAME & MAILING ADDRESS OF LANDOWNER  
**Carol Clark**  
**Whisper Lane**  
**Vanleave Mn**

WELL LOCATION SEC TOWNSHIP RANGE  
**34 4<sup>S</sup> 7<sup>W</sup>**

DISTANCE DIRECTION NEAREST TOWN  
**8** Miles **NORTH** of **Vanleave**

OTHER LANDMARK

WELL PURPOSE  Domestic,  Municipal,  Industrial,  Fish Pond, etc.

PUMP DATA

PUMP TYPE (Circle One):  
Submersible, Turbine,  Jet,  Flowing Well,  
Other (Describe) \_\_\_\_\_

POWER TYPE (Circle One):  
 Electric,  Tractor,  Diesel,  Gasoline,  Butane,  
Other (Describe) \_\_\_\_\_ H/P **2**

Pump Capacity (GPM) No. of Stages Setting Depth  
**5** **3** \_\_\_\_\_ FT.

PUMP TEST

Well yielded \_\_\_\_\_ GPM with  
a drawdown of \_\_\_\_\_ ft.  
after \_\_\_\_\_ hours of pumping

WELL DATA

Well Depth Casing Diameter (In.) Casing Length (Ft.)  
**228'** **2"** **218'**

Type of Casing Hole Depth Depth to Static Water Level  
**PVC** **240'** **140'**

TYPE OF COMPLETION: (Circle One or More):  
 Gravel Packed,  Underreamed,  Telescoped,  
 Natural Development,  Open Hole,  Other  
(Describe) \_\_\_\_\_

WELL GROUTED TO A DEPTH OF **2** FEET  
Type Grout (circle one):  Cement,  Bentonite, or Mix

LOG DATA

TYPE OF LOG RUN (Circle One):  
Electric, Gamma Ray, Density, Sonic,  No Log Run, Neutron,  
Other (Describe) \_\_\_\_\_

Name of Organization Running Log

SCREEN DATA

Diameter - Inches Length - Feet Slot Size - Inches  
**2"** **10'** **.004**

Screen Type Depth to Bottom - Feet  
**PVC Wrapped** **240'**

GEOLOGIC DATA (Office Use Only)

Surface Elev.	Geologic Unit	Unit Thickness	Depth to Top
Subs. SWL	Date	Analysis	Aquifer Test

Driller's Remarks

Top of Lap Pipe or Reduction in Casing


FEET IF TELESCOPED OR MORE THAN ONE SCREEN: USE BACK PAGE

DESCRIPTION OF FORMATIONS ENCOUNTERED	FROM	TO	FORMATIONS (Continued)	FROM	TO
Top Soil	0	2	<div style="border: 2px solid black; padding: 5px; display: inline-block;">RECEIVED</div> <b>JUL 21 1997</b> Dept. of Environmental Quality Office of Land & Water Resources		
Red Clay	2	7			
White Coarse Sand	7	44			
Blue Clay streaked	44	195			
Gray Coarse Sand	195	228			
Blue Clay	228	240			

IF MORE SPACE IS NEEDED, USE BACK

If well telescopes please sketch and show depths.

GROUND LEVEL

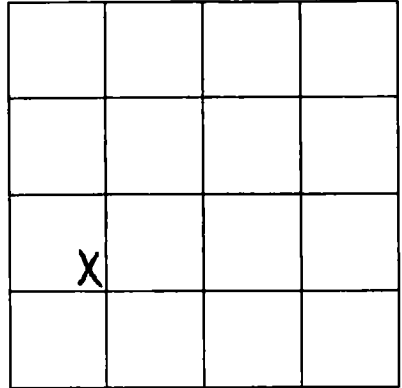

SECTION 34

Please indicate well location X.

ADDITIONAL INFORMATION

If more than one screen, show location of each on sketch.