

MISSISSIPPI DEPARTMENT OF ENVIRONMENTAL QUALITY
Office of Land and Water Resources

P. O. Box 10631
 Jackson, MS 39289-0631
WATER WELL DRILLERS LOG

COUNTY WHERE LOCATED
 Jackson

WELL NUMBER
 B-2036

CODED

DATE WELL COMPLETED
 1-8-01

PERMIT NUMBER

NAME OF DRILLING FIRM
 Best Water Well Service

NAME & MAILING ADDRESS OF LANDOWNER
 Gary Wright
 Cap Johnson Rd.
 Moss Point, Ms

WELL LOCATION: SEC 34 TOWNSHIP 4^N RANGE 6^W

DISTANCE 1 Miles **DIRECTION** NORTH of **NEAREST TOWN** WADE

OTHER LANDMARK

WELL PURPOSE: (Home, Irrigation, Municipal, Industrial, Fish Pond, etc.)
 Home

PUMP DATA

PUMP TYPE (Circle One):
 Submersible, Turbine, Jet, Flowing Well,
 Other (Describe) _____

POWER TYPE (Circle One):
 Electric, Tractor, Diesel, Gasoline, Butane,
 Other (Describe) _____ H/P 1

Pump Capacity (GPM) 12 **No. of Stages** 2 **Setting Depth** _____ **FT.**

PUMP TEST
 Well yielded _____ GPM with
 a drawdown of _____ ft.
 after _____ hours of pumping

WELL DATA

Well Depth <u>320'</u>	Casing Diameter (In.) <u>2"</u>	Casing Length (Ft.) <u>310'</u>
Type of Casing <u>PVC</u>	Hole Depth <u>320'</u>	Depth to Static Water Level <u>0'</u>

TYPE OF COMPLETION: (Circle One or More):
 Gravel Packed, Underreamed, Telescoped,
 Natural Development, Open Hole, Other
 (Describe) _____

LOG DATA

TYPE OF LOG RUN (Circle One):
 No Log Run,
 Electric, Gamma Ray, Density, Sonic, Neutron,
 Other (Describe) _____

Name of Organization Running Log

WELL GROUTED TO A DEPTH OF 20 **FEET**
 Type Grout (circle one): Cement, Bentonite, or Mix

GEOLOGIC DATA (Office Use Only)

Surface Elev.	Geologic Unit	Unit Thickness	Depth to Top
Subs. SWL	Date	Analysis	Aquifer Test

SCREEN DATA

Diameter - inches <u>2"</u>	Length - Feet <u>10'</u>	Slot Size - inches <u>.008</u>
Screen Type <u>PVC</u>	Depth to Bottom - Feet <u>320'</u>	

Driller's Remarks

Top of Lap Pipe or Reduction in Casing

FEET IF TELESCOPED OR MORE THAN ONE SCREEN: USE BACK PAGE


DESCRIPTION OF FORMATIONS ENCOUNTERED	FROM	TO
TOP SOIL	0	2
Brown Clay	2	13
White coarse sand, playground	13	78
Blue Clay	78	92
Gray coarse sand	92	320

FORMATIONS (Continued)	FROM	TO

REC'D MAY 17 2001

If well telescopes please
sketch and show depths.

GROUND LEVEL

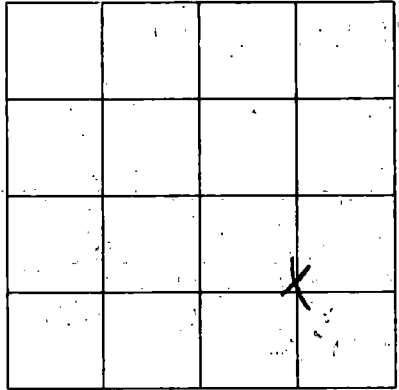

SECTION _____

Please indicate well location X.

ADDITIONAL INFORMATION

If more than one screen,
show location of each on sketch.