

JACKSON MISSISSIPPI BOARD OF WATER COMMISSIONERS

C 17
11-21-61

WATER WELL DRILLERS LOG

Date: Nov 21, 1961, Driller: Colville County Jackson

39

(1) Owner of Land: Roy Carter
(Name)

Wade
(Address)

(2) Location: NW 1/4 SE 1/4, Sec 27 T4R6

6 miles North of Wade
(distance) (direction) (Nearest Town)

(3) Topography: Hilly
(Hilly) (Flat) (Level)

(4) Purpose of Well: Domestic
(Domestic Irrigation
Municipal, Industrial, Other)

Description & Color of Materials Sand, Clay, Red Clay, Shell, etc.	Thick- ness Feet	Depth Feet
Slush		21
Sand	94	115
Yellow Clay	11	126
Blue Clay	122	248
Sand	3	251
Clay	33	284
Sand	57	341
		T.D.

Information upon completion of well:

(1) Diameter 1 1/4 inches.

(2) Total Depth 321 feet.

(3) Water Level + 3' feet below top of ground.

(4) Cased to _____, Size _____


(5) Screen: Size 1 1/4, Length 10'

(6) Were any formations sealed against pollution?
_____ yes, no.

If YES depth of formation _____

Why _____

Drillers Remarks: _____

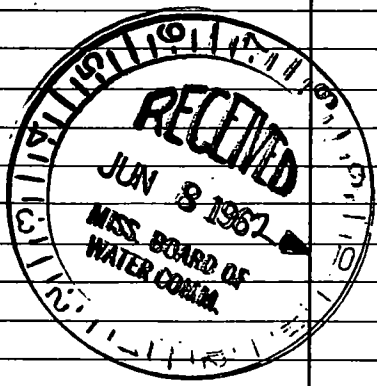

Well No. 397

(Use Back Side)

11
12
13
200