

JACKSON

C 20

WATER WELL DRILLERS LOG

C 301

Date: 1-17-64, 1964, Driller: Colville Water Supply Co County JACKSON
(Name)

(1) Owner of Land: J B Goff (Name)
Wade Miss (Address)

(2) Location: SE 1/4, SE 1/4, Sec. 27 T45R6W
1 1/2 miles North, of Wade (distance) (direction) (Nearest Town)

(3) Topography: (Hilly) (Flat) (Level) [checked]

(4) Purpose of Well: (Domestic Irrigation) (Municipal, Industrial, Other) [checked]


Description & Color of Materials Sand, Clay, Red Clay, Shell, etc.	Thick- ness Feet	Depth Feet
0 Sand & red clay	10	White sand
21 White sand	42	" "
50 Gravel	63	Gravel
84 yellow clay	105	
126 Blue clay	150	
154 Sand	154	Blue clay
246 Britty clay	252	Britty clay
270 " " "	294	Sand
325		

Information upon completion of well:

- (1) Diameter: 1 1/4 inches.
- (2) Total Depth: 325 feet.
- (3) Water Level: + 6' 11" feet below top of ground.
- (4) Cased to: _____, Size: _____
- (5) Screen: Size: 1 1/4, Length: 10'
- (6) Were any formations sealed against pollution?
_____ yes, _____ no. [checked]

If YES depth of formation _____
Why _____

Drillers Remarks: This well flows about 3 gals per m.

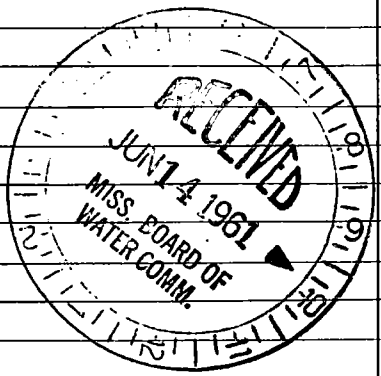

(Use Back Side)

Well No. 28

