

JACKSON

C 23

8-1-62

WATER WELL DRILLERS LOG

Date Aug 1, 1962 Driller: Flora Colville County Jackson  
 (Name)

(1) Owner of Land: <u>Willie Green</u> (Name)	Description & Color of Materials Sand, Clay, Red Clay, Shell, etc.	Thick- ness Feet	Depth Feet
<u>Wade</u> (Address)	<u>0-10 Sandy clay</u>		
(2) Location: <u>SE 1/4, SE 1/4, Sec. 27 T45R6W4</u>	<u>10-21 clay</u>		
<u>1</u> miles <u>north</u> of <u>Wade</u> (distance) (direction) (Nearest Town)	<u>21-32 clay</u>		
(3) Topography: <u>hilly</u> (Hilly) (Flat) (Level)	<u>32-42 sand &amp; gravel</u>		
(4) Purpose of Well: <u>Domestic</u> (Domestic Irrigation Municipal, Industrial, Other)	<u>42-63 sand &amp; gravel</u>		
	<u>63-84 gravel</u>		
	<u>84-88 gravel</u>		
	<u>88-105 Hard clay</u>		
	<u>105-126 clay</u>		

Information upon completion of well:

(1) Diameter 1 1/4 inches.

(2) Total Depth 346 feet.

(3) Water Level + 8' feet below top of ground.

(4) Cased to \_\_\_\_\_, Size \_\_\_\_\_

(5) Screen: Size 1 1/4, Length 10'


(6) Were any formations sealed against pollution?  
 \_\_\_\_\_ yes, X no.

If YES depth of formation \_\_\_\_\_

Why \_\_\_\_\_

Drillers Remarks: \_\_\_\_\_

<u>126-146 clay</u>		
<u>146-166 clay</u>		
<u>166-186 clay</u>		
<u>186-203 clay</u>		
<u>203-204 Rock</u>		
<u>204-206 clay</u>		
<u>206-226 clay</u>		
<u>226-246 Britty clay</u>		
<u>246-266 clay</u>		
<u>266-286 clay</u>		
<u>286-290 Straps</u>		
<u>290-305 sand</u>		
<u>305-306 clay</u>		
<u>306-326 sand</u>		
<u>326-346 sand</u>		

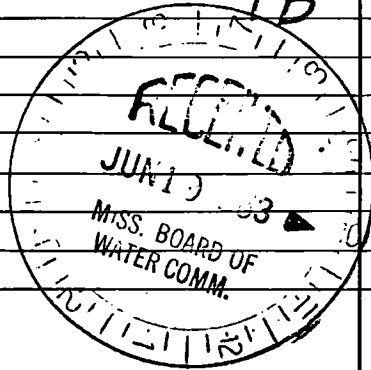

(Use Back Side)

Well No. 162

