

JACKSON MISSISSIPPI BOARD OF WATER COMMISSIONERS

C 25

12-4-62

WATER WELL DRILLERS LOG

Date: Dec. 4, 1962, Driller: George Colville County Jackson

(Name)

(1) Owner of Land: Elmer Hamilton
(Name)
Wade, Mississippi
(Address)

(2) Location: SW 1/4, SW 1/4, Sec. 22 T46R6W
3 1/2 miles NORTH of Wade
(distance) (direction) (Nearest Town)

(3) Topography: FLAT
(Hilly) (Flat) (Level)

(4) Purpose of Well: Domestic
(Domestic Irrigation
Municipal, Industrial, Other)

Description & Color of Materials Sand, Clay, Red Clay, Shell, etc.	Thick- ness Feet	Depth Feet
<u>sand</u>	<u>10</u>	<u>10</u>
<u>White Clay</u>	<u>11</u>	<u>21</u>
<u>Yellow Clay</u>	<u>29</u>	<u>50</u>
<u>Yellow Sand</u>	<u>13</u>	<u>63</u>
<u>GRAVEL</u>	<u>21</u>	<u>84</u>
<u>Blue Clay</u>	<u>21</u>	<u>105</u>
<u>Sandy Clay</u>	<u>15</u>	<u>120</u>
<u>Blue Clay</u>	<u>124</u>	<u>244</u>
<u>GRAY SAND</u>	<u>31</u>	<u>325</u>

Information upon completion of well:

(1) Diameter 1 1/4 inches.

(2) Total Depth 325 feet.

(3) Water Level 8' - 8" Above feet ~~below~~ top of ground.

(4) Cased to 315, Size 1 1/4


(5) Screen: Size 80 GA., Length 10 ft.

(6) Were any formations sealed against pollution?
 yes, no.

If YES depth of formation

Why

Drillers Remarks:

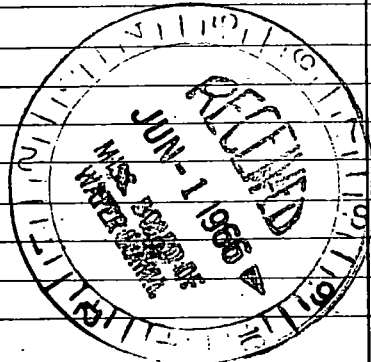

(Use Back Side)

Well No. 96

