

4 9

Jackson
C 26
11-63

MISSISSIPPI
 BOARD OF WATER COMMISSIONERS
 416 North State Street
 Jackson, Mississippi 39201

WATER WELL DRILLERS LOG

Nov 14 19 63 White Water Supply Jackson
 date well completed firm name county well located

LANDOWNER: Onie Pierce

description of formations encountered	from	to
<u>sand</u>	<u>0</u>	<u>87</u>
<u>clay</u>	<u>87</u>	<u>194</u>
<u>sand</u>	<u>194</u>	<u>214</u>

Salem Community Miss.
(mailing address)


WELL LOCATION: NE NW
 sec. 5 T. 4 N. R. 6 E.
12 miles south of Suedale
 (distance) (direction) (nearest town)

WELL PURPOSE: home
(home, irrigation, municipal, industrial)

WELL COMPLETION DATA:

- (1) diameter (inches) 2
- (2) total depth (feet) 214
- (3) static water level (feet) 9 below above top of ground.
- (4) casing _____ (material), _____ (depth), _____ (size) if telescope see back.
- (5) screen 10, 204 (length), (depth to top)
2, Stainless (size), (material)
- (6) pump _____ (HP), _____ (yield gpm)
(type power)
- (7) electric log no (yes or no)
(organization running log)
- (8) how well bottom plugged Blahy


DRILLERS REMARKS:

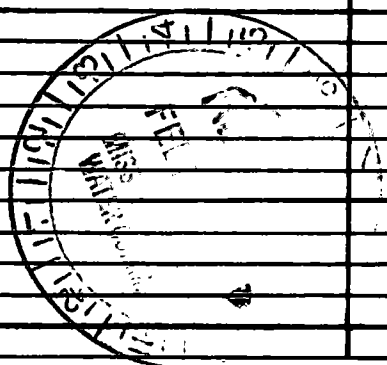

If well telescopes please sketch and show depths.

GROUND LEVEL

NE NW

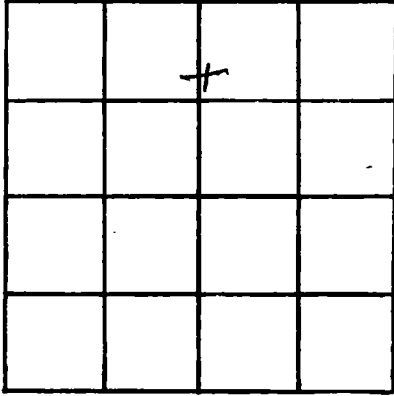

SECTION 5

Please indicate well location X.

ADDITIONAL INFORMATION

Lined area for additional information.

If more than one screen, show locations of each on sketch.