

69

Jackson
C 27
4-63

MISSISSIPPI  
BOARD OF WATER COMMISSIONERS  
416 North State Street  
Jackson, Mississippi 39201

WATER WELL DRILLERS LOG

April 15 1963 Colville Water Supply Co. Jackson  
date well completed firm name county well located

LANDOWNER: James Sherman

Cedar Creek Community

Rt Passagoula (mailing address)

WELL LOCATION:

sec. 8 T ~~4~~ N R 6 E  
 20 miles North of Moss Point  
 (distance) (direction) (nearest town)

WELL PURPOSE: home  
 (home, irrigation, municipal, industrial)


WELL COMPLETION DATA:

- (1) diameter (inches) 1 1/4
- (2) total depth (feet) 220
- (3) static water level (feet) 5 below above top of ground. Flow 8 G.P.M.
- (4) casing (material) (depth) (size) if telescope see back.
- (5) screen 5 215 (length) (depth to top) 1 1/4 BRASS (size) (material)
- (6) pump (HP) (yield gpm) (type power)
- (7) electric log No (yes or no) (organization running log)
- (8) how well bottom plugged B.P. valve

description of formations encountered

from to

Clay	0	18
Sand	18	38
Clay	38	42
Sand's Gravel	42	77
Yellow Clay	77	95
Sand	95	100
Clay	100	158
Fine sand	158	187
Clay	187	189
Sand	189	220

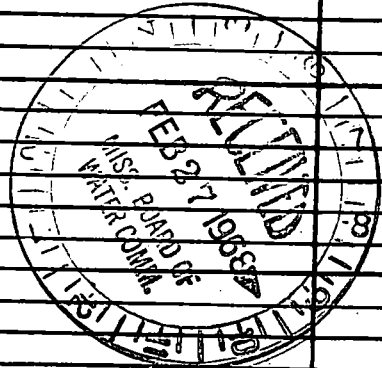

DRILLERS REMARKS:

If well telescopes please sketch and show depths.

GROUND LEVEL

SW SE

		X	

SECTION 8

Please indicate well location X.

ADDITIONAL INFORMATION

If more than one screen, show locations of each on sketch.