

JACKSON

32

8-31-68

MISSISSIPPI BOARD OF WATER COMMISSIONERS
416 North State Street
Jackson, Mississippi 39201

DED

WATER WELL DRILLERS LOG

8-31 1968 Coast Water Well Serv. Jackson
date well completed firm name county well located

LANDOWNER: Leo Helms

836 Forest Dr.

Pracogata Miss.
(mailing address)

| description of formations encountered | from | to |
|---------------------------------------|--------------------|------------|
| | <u>muck + clay</u> | <u>0</u> |
| <u>coarse white sand</u> | <u>18</u> | <u>47</u> |
| <u>blue clay + sandy shale</u> | <u>47</u> | <u>210</u> |
| <u>sand - fine to med.</u> | <u>210</u> | <u>230</u> |

WELL LOCATION:

sec. 38 T. 4 N. R. 6 W. S. 5
14 miles S of Lucedale
(distance) (direction) (nearest town)

WELL PURPOSE: Camp
(home, irrigation, municipal, industrial)

WELL COMPLETION DATA:

- (1) diameter (inches) 2"
- (2) total depth (feet) 230
- (3) static water level (feet) 8 below above top of ground.
- (4) casing galv. 220'
(material) (depth)
2" if telescope see back.
(size)
- (5) screen 10' 220'
(length) (depth to top)
2" wrapped stainless
(size) (material)
- (6) pump NONE 8
(HP) (yield gpm)
NONE
(type power)
- (7) electric log NO
(yes or no)
(organization running log)
- (8) how well bottom plugged Back
Wash down

CODED


JAN 24 1969

MISS. BD. OF WATER COM.

DRILLERS REMARKS:

If well telescopes please sketch and show depths.

GROUND LEVEL

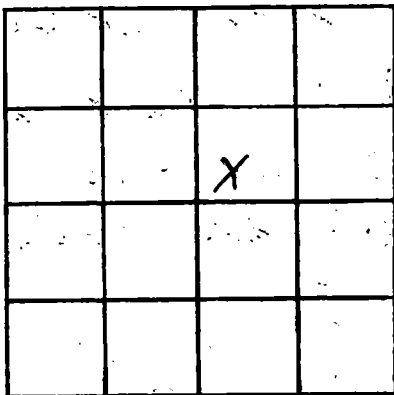

SECTION 38

Please indicate well location X.

ADDITIONAL INFORMATION

If more than one screen, show locations of each on sketch.