

Jackson  
 C 34  
 7-65

MISSISSIPPI  
 BOARD OF WATER COMMISSIONERS CODED  
 416 North State Street  
 Jackson, Mississippi 39201

WATER WELL DRILLERS LOG

July 30 1965 Levell Water Supply Jackson  
 date well completed firm name county well located

LANDOWNER: Betty Janner  
Wade, Miss  
 (mailing address)


description of formations encountered	from	to
Clay	0	22
Clay	22	44
Sand & gravel	44	66

WELL LOCATION:  
 sec. 34 T. 4 N. 4 R. 6 E.  
3 miles West of Paul.  
 (distance) (direction) (nearest town)

WELL PURPOSE: home  
 (home, irrigation, municipal, industrial)


- WELL COMPLETION DATA:
- diameter (inches) 2 X 1 1/4
  - total depth (feet) 66
  - static water level (feet) 27-6 (below/above top of ground)
  - casing galv (material), \_\_\_\_\_ (depth)  
 \_\_\_\_\_ if telescope see back.  
 (size)
  - screen 5 61 (length) (depth to top)  
1 1/4 Copper gauze (size) (material)
  - pump \_\_\_\_\_ (HP) \_\_\_\_\_ (yield gpm)  
 \_\_\_\_\_ (type power)
  - electric log no (yes or no)  
 \_\_\_\_\_ (organization running log)
  - how well bottom plugged BFW

DRILLERS REMARKS: pump installed by owner

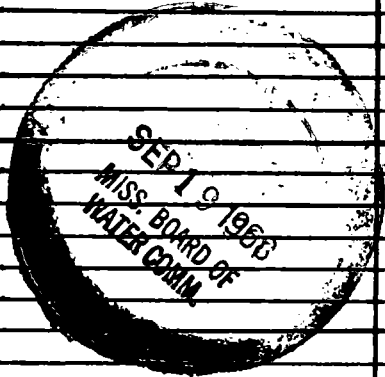

If well telescopes please sketch and show depths.

GROUND LEVEL

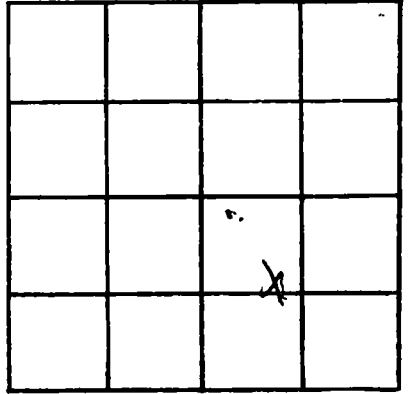

SECTION \_\_\_\_\_

Please indicate well location X.

ADDITIONAL INFORMATION

If more than one screen,  
show locations of each on sketch.