

JACKSON
 C 35
 4-21-66

MISSISSIPPI
 BOARD OF WATER COMMISSIONERS
 416 North State Street
 Jackson, Mississippi 39201

WATER WELL DRILLERS LOG

April 21 1966 Colville Water Supply Co., Inc. Jackson
 date well completed firm name county well located

LANDOWNER: H. Edgall
 Golf
 Wade, Miss.
 (mailing address)

description of formations encountered	from	to
	clay	0
sand	35	68

WELL LOCATION:
 sec. 35 T 4 N R 6 E W
 2 miles North of Wade
 (distance) (direction) (nearest town)

WELL PURPOSE: home
 (home, irrigation, municipal, industrial)

WELL COMPLETION DATA:

(1) diameter (inches) 2

(2) total depth (feet) 68

(3) static water level (feet) 13 ^{below} above top of ground.

(4) casing galv. 63
 (material) (depth)
 (size) If telescope see back.

(5) screen 5' 63
 (length) (depth to top)
 2" plastic
 (size) (material)

(6) pump (HP) (yield gpm)
 (type power)

(7) electric log no
 (yes or no)
 (organization running log)

(8) how well bottom plugged B.P. plug


DRILLERS REMARKS: pump installed by owner

LOGED

MAR 27 1966
 MISSISSIPPI STATE WATER BOARD

If well telescopes please sketch and show depths.

GROUND LEVEL

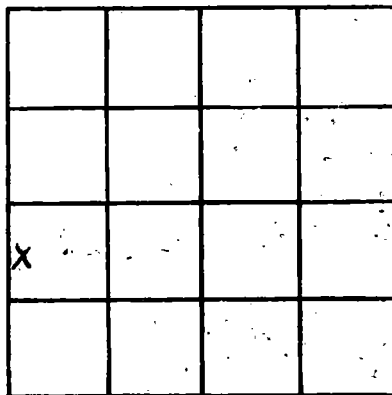

SECTION 35

Please indicate well location X.

ADDITIONAL INFORMATION

If more than one screen, show locations of each on sketch.