

Jackson
 C 36
 7-29-67

MISSISSIPPI
 BOARD OF WATER COMMISSIONERS
 416 North State Street
 Jackson, Mississippi 39201

INDEXED

WATER WELL DRILLERS LOG

July 29 1967 Colville Water Sup Jackson
 d. well completed firm name county well located


LANDOWNER: <u>Mrs. E. Jeff</u>	description of formations encountered	from	to
<u>Wade Mine</u> (mailing address)	<u>Sand & Clay str</u> <u>sand</u>	<u>0</u> <u>22</u>	<u>22</u> <u>66</u>
WELL LOCATION:			
sec. <u>35</u> T. <u>4</u> N. R. <u>6</u> E. <u>1</u> miles <u>N</u> of <u>Wade</u> (distance) (direction) (nearest town)			
WELL PURPOSE: <u>home</u> (home, irrigation, municipal, industrial)			
WELL COMPLETION DATA:			
(1) diameter (inches) <u>2</u>			
(2) total depth (feet) <u>66</u>			
(3) static water level (feet) <u>19</u> ^{below} above top of ground.			
(4) casing <u>galv</u> (material) (depth) (size) if telescope see back.			
(5) screen <u>5</u> <u>61</u> (length) (depth to top)			
<u>2</u> <u>stainless</u> (size) (material)			
(6) pump _____ (HP) (yield gpm)			
(type power)			
(7) electric log <u>no</u> (yes or no)			
(organization running log)			
(8) how well bottom plugged <u>BPI only</u>			
DRILLERS REMARKS: <u>pump installed by owner</u>			

APR 21 1968

MISS. BD. OF
 WATER COMMISSIONERS

If well telescopes please sketch and show depths.

GROUND LEVEL

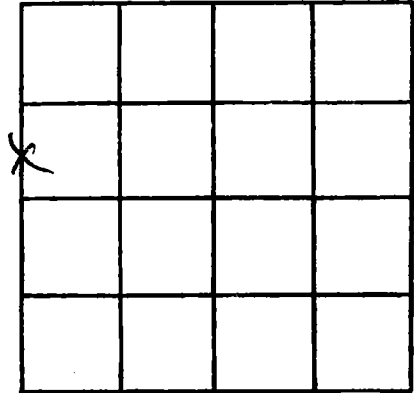

SECTION 35

Please indicate well location X.

ADDITIONAL INFORMATION

If more than one screen, show locations of each on sketch.