

Jackson
 E-39
 9-3-68

MISSISSIPPI
 BOARD OF WATER COMMISSIONERS
 416 North State Street
 Jackson, Mississippi 39201

CODED

WATER WELL DRILLERS LOG

Sept 3 1968 Colville Water Supply Jackson
 date well completed firm name county well located


LANDOWNER: <u>Mack Green</u>	description of formations encountered	from	to
<u>Wade 7 Min</u> (mailing address)	<u>clay</u> <u>sand and gravel</u>	<u>0</u> <u>44</u>	<u>44</u> <u>79</u>
WELL LOCATION: sec. <u>27</u> T. <u>4</u> N R. <u>6</u> E <u>2 1/2</u> miles <u>N</u> of <u>Wade</u> (distance) (direction) (nearest town)	<u>clay</u> <u>sand</u>	<u>79</u> <u>323</u>	<u>298</u> <u>323</u>
WELL PURPOSE: <u>home</u> (home, irrigation, municipal, industrial)			
WELL COMPLETION DATA: (1) diameter (inches) <u>2</u> (2) total depth (feet) <u>323</u> (3) static water level (feet) <u>5-10</u> <u>below</u> <u>above</u> top of ground. (4) casing <u>galv</u> (material) (depth) (size) If telescope see back. (5) screen <u>4</u> <u>319</u> (length) (depth to top) <u>2</u> <u>stainless</u> (size) (material) (6) pump _____ (HP) _____ (yield gpm) (type power) _____ (7) electric log <u>no</u> (yes or no) (organization running log) _____ (8) how well bottom plugged <u>BPKM</u>			
DRILLERS REMARKS: <u>pump installed by owner</u>			

JAN - 8 1970

MISS. BD. OF
 WATER COMM.

If well telescopes please sketch and show depths.

GROUND LEVEL

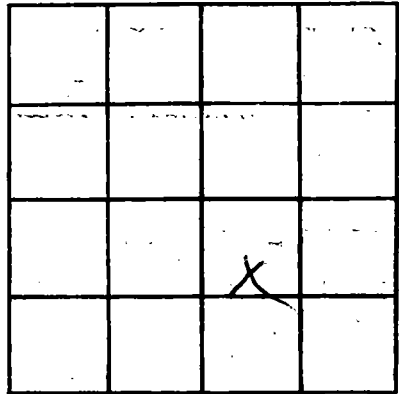

SECTION 27

Please indicate well location X.

ADDITIONAL INFORMATION

If more than one screen, show locations of each on sketch.