

Jackson
 C 41
 5-11-70

MISSISSIPPI
 BOARD OF WATER COMMISSIONERS
 416 North State Street
 Jackson, Mississippi 39201

VOIDED

WATER WELL DRILLERS LOG

5/11/70 date well completed
 M & H Well Co. firm name
 Jackson county well located

LANDOWNER: C. F. Kirkwood
 Wade Miss
 (mailing address)

WELL LOCATION:
 sec 34 T 4 N R 6 E 225
 1 miles N of Wade
 (distance) (direction) (nearest town)

WELL PURPOSE: Home
 (home, irrigation, municipal, industrial)

- WELL COMPLETION DATA:
- (1) diameter (inches) 7"
 - (2) total depth (feet) 68
 - (3) static water level (feet) 24 below top of ground
 - (4) casing Plastic 58 (material) (depth)
 - (5) screen 10ft 58 (length) (depth to top)
 2" Plastic (size) (material)
 - (6) pump 1 (HP) 15 (yield gpm)
 Electric (type power)
 - (7) electric log No (yes or no)

(organization running log)
 (8) how well bottom plugged Back wash valve

description of formations encountered	from	to
Dirt	0	2
Red sand	2	12
Yellow clay	12	
Dirt	0	2
Yellow clay	2	12
White clay	12	19
Yellow clay	19	68
Sand		


DRILLERS REMARKS:

MAY 25 1970

MISS. BO. OF WATER COMM.

If well telescopes please sketch and show depths.

GROUND LEVEL

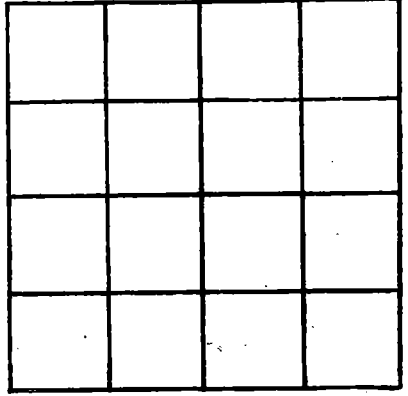

SECTION _____

Please indicate well location X.

ADDITIONAL INFORMATION

If more than one screen, show locations of each on sketch.