

JACKSON

C 42

7-21-70

MISSISSIPPI
 BOARD OF WATER COMMISSIONERS
 416 North State Street
 Jackson, Mississippi 39201

CODED

WATER WELL DRILLERS LOG

July 21 1970

1970 Cobble Water Supply

Jackson county well located

LANDOWNER: George

Cobville

Cobble Creek Estate
(mailing address)

description of formations encountered

from

to

<u>sand</u>	<u>0</u>	<u>50</u>
<u>clay</u>	<u>50</u>	<u>150</u>
<u>sand</u>	<u>150</u>	<u>163</u>

WELL LOCATION:

sec. 38 T 4 N R. 60 E
 (distance) miles (direction) of Wade (nearest town)

WELL PURPOSE: Camp

(home, irrigation, municipal, industrial)

WELL COMPLETION DATA:

- (1) diameter (inches) 2
- (2) total depth (feet) 163
- (3) static water level (feet) 3 below top of ground. above
- (4) casing galv. 158
(material) (depth)
(size) If telescope see back.
- (5) screen 5 158
(length) (depth to top)
2 Plastic
(size) (material)
- (6) pump 0
(HP) (yield gpm)
(type power)
- (7) electric log no
(yes or no)
(organization running log)
- (8) how well bottom plugged BPC Valve

CODED


SEP 11 1970

DRILLERS REMARKS:

MISS. BD. OF
WATER COMM.

If well telescopes please sketch and show depths.

GROUND LEVEL

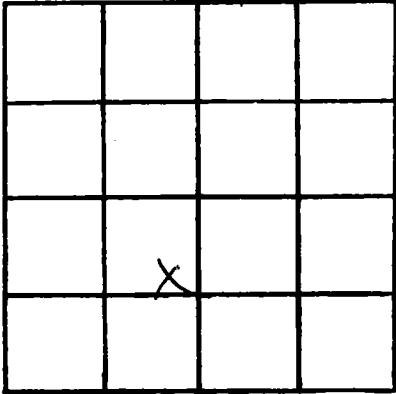

SECTION 38

Please indicate well location X.

ADDITIONAL INFORMATION

Multiple horizontal lines for writing additional information.

If more than one screen, show locations of each on sketch.