

Jackson

C 45

6-11-70

MISSISSIPPI BOARD OF WATER COMMISSIONERS  
416 North State Street  
Jackson, Mississippi 39201

**CODED**

WATER WELL DRILLERS LOG

June 11 1970 data well completed  
Cobalt Water Supply firm name  
Jackson county well located

LANDOWNER: S. J. Browning

Wade Miss (mailing address)

WELL LOCATION:

sec. 32 T 4 N R 6 E  
20 miles North of M.P.  
(distance) (direction) (nearest town)

WELL PURPOSE: Home (home, irrigation, municipal, industrial)

WELL COMPLETION DATA:

- (1) diameter (inches) 2
- (2) total depth (feet) 321
- (3) static water level (feet) 1 below top of ground
- (4) casing Galv. 316 (material) (depth)  
(size) If telescope see back.
- (5) screen 5' 321 (length) (depth to top)  
2 Stainless (size) (material)
- (6) pump (HP) (yield gpm)  
(type power)
- (7) electric log no (yes or no)  
(organization running log)
- (8) how well bottom plugged B.P. Valve

description of formations encountered

from to

sandy clay	0	48
shand	48	50
clay	50	304
quid	304	321

**CODED**


JUL 27 1970

DRILLERS REMARKS: pump installed by owner

MISS. BD. OF WATER COMM.

If well telescopes please sketch and show depths.

GROUND LEVEL

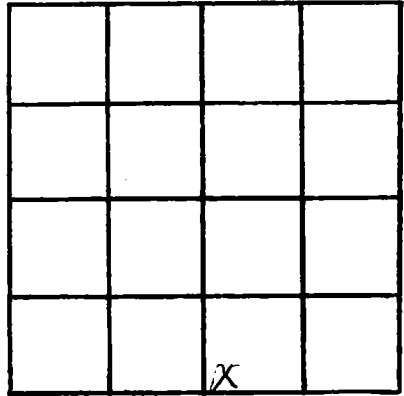

SECTION 22

Please indicate well location X.

ADDITIONAL INFORMATION

If more than one screen,  
show locations of each on sketch.