

F

JACKSON
C47
2-27-71

MISSISSIPPI
BOARD OF WATER COMMISSIONERS
416 North State Street
Jackson, Mississippi 39201

CODED

WATER WELL DRILLERS LOG

2/27/71 date well completed 19 71 M + H. Well Co firm name Jackson county well located

LANDOWNER: Phillip & the Jr.
Wade Miss

description of formations encountered	from	to
Dirt	0	1
Red dirt	1	8
White clay	8	12
Sand	12	24
Black clay	24	26
Sand	26	57

(mailing address)

WELL LOCATION:
sec. 5 T 4 N R 6 E
6 miles NW of Wade
(distance) (direction) (nearest town)

WELL PURPOSE: Home
(home, irrigation, municipal, industrial)

WELL COMPLETION DATA:

(1) diameter (inches) 2 1/2

(2) total depth (feet) 57

(3) static water level (feet) 17 below above top of ground.

(4) casing Galv. 47
(material) (depth)

_____ if telescope see back.
(size)

(5) screen 10ft 47
(length) (depth to top)

2 1/2 Plastic
(size) (material)

top put pump
(6) pump on later (HP) _____ (yield gpm)

_____ (type power)

(7) electric log No
(yes or no)

_____ (organization running log)

(8) how well bottom plugged Back
Wash Valve

DRILLERS REMARKS:


CODED

MAR 3 - 1971

MISS. BD. OF
WATER COMM.

If well telescopes please sketch and show depths.

GROUND LEVEL

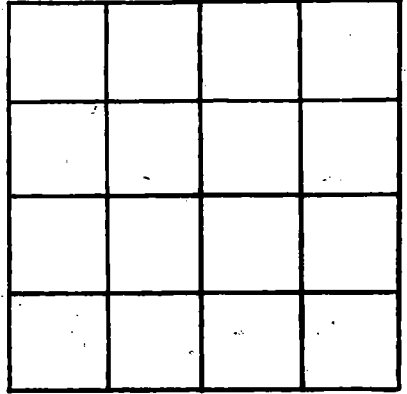

SECTION _____

Please indicate well location X.

ADDITIONAL INFORMATION

If more than one screen, show locations of each on sketch.