1				
State V	Vell Report	·····		
	-	For Office Use Only:		
E COUNTRY NAC DAOTA	Part 1 at of Environmental Quality A	: 6		
	and Water Resources	Aquifer:		
	Box 10631	Vell #: <u>C-99</u>		
Duller: Thenen S. Hawka Jackson, N	AS 39289-0631	. S. Elevation:		
)961-5210			
(601)35	54-6938 (fax)	E-log #:		
State Law requires that this report be prepared by the 30 days of completion of drilling of the well.	driller in detail and filed with	the Department within		
Well Owner Information	Well La	ocation		
Owner Name Doniel Sayre	Latitude: 30 • 43 • 52 "			
Mailing Address: 26162 Hwy 63-5	3 i Method of Lat/Long (circle one):	Conventional Survey, 34		
	USGS quad, Hand-held GI	PS, Survey-grade GPS		
1 40-16 ms 2015)	NE 1/ SW 1/ Sec 4 /	Twn T45 Rng RUW		
Lucedalc MS 39452 City State Zip Code	Distance Direction	Nearest Town		
		Hurley		
Telephone No. (228) 623-9493		•		
Well	Data			
Purpose of Well (circle one) Home Industrial Public Supply Irrigation Fish Culture Other:				
Date well drilling started: 01-06-06 Date well drilling completed: 01-06-06				
If flowing, method of flow regulation: Valve Other (describe)				
Static Water Level: feet for or below (circle one)	land surface Date measured: O	1-07-06		
Method of Measurement (circle one) steel taps electric tape air line other:				
Hole depth: <u>209</u> Well depth: <u>209</u> Well grouted to a depth of <u>12</u> feet				
Type of grout (circle one): Cement Bentonite Mix				
Casing length: <u>199</u> feet Casing diameter: <u>2</u> inches Type of casing: <u>WOP</u>				
Screen length: 10 feet Screen diameter: 2 inches Type of screen: PUL WOP				
Screen slot size: <u></u>				
Type of completion (circle all applicable): Gravel nacked Underreamed Telescoped Open hole Natural Development				
Other (describe):				
Top of lap pipe or reduction in casing:feet. If telescoped or more than one screen, describe on back of page				
Logs run (circle all applicable): Electric Gamma Ray Density Sonic Neutron Other:				
Name of organization running log(s): I certify that the well was drilled, constructed, and completed in accordance with all applicable requirements of the Mississippi				
Department of Environmental Quality and/or the Mississippi Department of Health regulations and state laws.				
Michael S. Havard 0-673	Mill	HA		
Print Name of Water Well Contractor and License No.	Signature of Wa	ater Well Contractor		

` د

RECEIVED FEB ; 5 2006 BY: OLWR



If well telescopes please sketch below and show depths.


Ground Level

Ŧ

Description of Formations Encountered	From	То
Topsand Clay	0	5
Clay	5	12
srit	12	26
Clay	26	89
SIL	89	95
Clay	95	165
Stilt and fine Sand	145	185
Classe	185	195
Sand (med)	195	201
·		
······································		l
······································		
	L	

If more than one screen, show location of each on sketch

Signature of Water Well Contractor

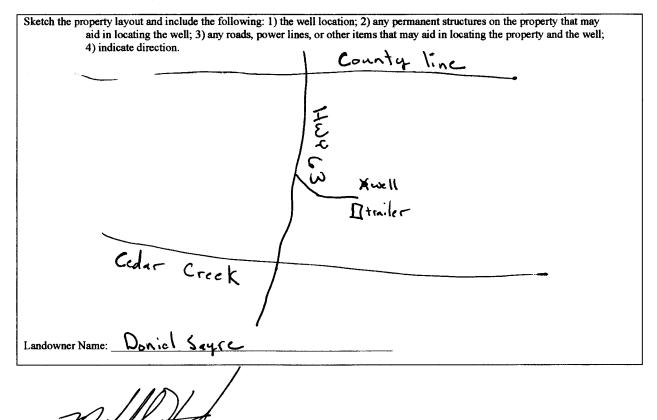

RECEIVED FEB 1 5 2006 BY: OLWR

	STATE W	ELL REPORT		
	Part 2		For Office Use Only:	
County: Jackson	Pump Installer'	s Completion Report		
Permit #:		nt of Environmental Quality and Water Resources	Aquifer:	
		and water Resources Box 10631		
Driller: Michaels, Havard		MS 39289-0631	well #: <u>C-</u> C ₁ C ₁ C	
Date completed: 01-09-04)961-5210	Elevation:	
	(601)35	54-6938 (fax)		
This report should be prepared by t installation of pump.		ail and filed with the Departm	ent within 30 days of the	
Well Owner Informa	r Information		Well Location	
Owner Name: Doniel Sayre	Latitude: N30°43,52		Longitude: <u>W88°55, 57</u>	
Mailing Address:	Method of Lat/Long (circle or		one): Conventional Survey,	
20162 HW	Y 63-5 USGS quad, Can		I-held GPS Survey-grade GPS	
Lucedale M. City State	<u>S 39452</u> Zip Code <u>14</u> <u>14</u> Sec <u>4</u>		4 Twn T45 Rng RLW	
City State	Distance Direction		Nearest Town	
Telephone No. (228) 623 - 949	3	<u> </u>		
Pump Type	-	Power Type		
Circle one		Circle one		
Air Lift 🕖	Submersible	Diesel Engine Gasol	ine Engine Natural Gas	
Bucket Piston	Turbine	Electric Motor Hand	I Tractor PTO	
Centrifugal Rotary	Flowing Well		r (specify):	
Other (specify):			or: 1HP	
Date Pump Installed: 01-09-01	<u>م</u>	Setting Depth:	<u>b</u> feet	
Rated Pump Capacity: 10	_Gallons Per Minute	Number of Stages:	2	
Pump Test Data		Method of Measuring Water Level		
Date Well Tested: 01-07-06			Circle one	
	t Below Land Surface		easuring Line Steel Tape	
Pumping Water Level (B):Feet	Below Land Surface	Other (specify):		
Drawdown [(B) - (A)]:Feet	t Below Land Surface	For flowing well, measured	shut in head:feet	
Test Pumping Rate: 00 15	_Gallons Per Minute	Well yielded GPM with a drawdown of		
Duration of Pump Test (minimum 4 hours)	: <u> </u>	<u>9</u> feet after <u>15</u> hours of pumping		
	·····		A	
I HEREBY CERTIFY that the above states	ments are true to the best of	of my knowledge.		
Michael S. Haugrd Print Name of Pump Installer and License	No. (if applicable)	Signature of Pump	Installer	

• •

> RECEIVED FEB 1 5 2006 BY: OLWR