F	State W	ell Report				
County: TUCKSON		art 1	For Office Use Only:			
•		t of Environmental Quality	Aquifer:			
Permit #:		and Water Resources	Well #: C-102			
Driller Water Well SRV.		Box 10631 IS 39289-0631	L. S. Elevation:			
Date drilling completed:		961-5210	L. S. Elevation:			
		4-6938 (fax)	E-log #:			
State Law requires that this report be prepared by the driller in detail and filed with the Department within 30 days of completion of drilling of the well.						
Well Owner Informs		Well	Location			
Owner Name Camille Moore		Latitude: 30 • 43 · 390 · Longitude: 088 32 · 751 ··				
Mailing Address: Polktowr	1 Rd		Long (circle one): Conventional Survey,			
		USGS quad, Hand-held	GPS, Survey-grade GPS			
Moss Point MS 39562		<u>NW 1/2 SW 1/2 Sec 42 Twn T45 RngR6W</u>				
Telephone No. (208) 588 - 0335		Distance Direction Nearest Town Miles of				
	Weil	Data				
Purpose of Well (circle one Home Ind	ustrial Public Supply	Irrigation Fish Culture	Other:			
Purpose of Well (circle one Home Industrial Public Supply Irrigation Fish Culture Other: Date well drilling started:O(0 Date well drilling completed:O(0)						
If flowing, method of flow regulation: Va						
Static Water Level:						
Method of Measurement (circle one) steel tape electric tape (air line) other:						
Hole depth: <u>286</u> Well depth: <u>286</u> Well grouted to a depth of <u>10</u> feet						
	Bentonite Mix		0.10			
Casing length: 2710_feet Casing diameter:inches Type of casing:						
Screen length: 10_feet Screen diameter: 2_inches Type of screen: 2						
Screen slot size: <u>e COS</u> inches	Setting depth: From _	d 70 feet to _	80 feet			
Type of completion (circle all applicable): Gravel packed Underreamed Telescoped Open hole Natural Development						
Other (describe):						
Top of lap pipe or reduction in casing:feet. If telescoped or more than one screen, describe on back of page						
Logs run (circle all applicable). No log run Electric Gamma Ray Density Sonic Neutron Other:						
Name of organization running log(s): I certify that the well was drilled, constr	ucted, and completed in a	accordance with all applicable	e requirements of the Mississippi			
Department of Environmental Quality and/or the Mississippi Department of Health regulations and state laws.						
Jack Ridadell	0-472	h	Raddel			
Print Name of Water Well Contractor and	License No.	Signature of	Water Well ComperCEIVED			
		V	AUG 1 5 2006			

د **ب** ۲

BY: OLWR

C-102

If well telescopes please sketch below and show depths.


Ground Level

۰,

 Description of Formations Encountered TOP SOIL Red CLAY White Course Sand Blue CLAY White COURSE Sand	From To <i>Q</i> <i>Q</i> <i>15</i> <i>15</i> <i>16</i> <i>20</i> <i>30</i> <i>4</i> <i>5</i> <i>4</i> <i>5</i> <i>5</i> <i>4</i> <i>5</i> <i>5</i> <i>4</i> <i>5</i> <i>5</i> <i>4</i> <i>5</i> <i>5</i> <i>5</i> <i>5</i> <i>5</i> <i>5</i> <i>5</i> <i>5</i>
1 1	

If more than one screen, show location of each on sketch

Signature of Water Well Contra

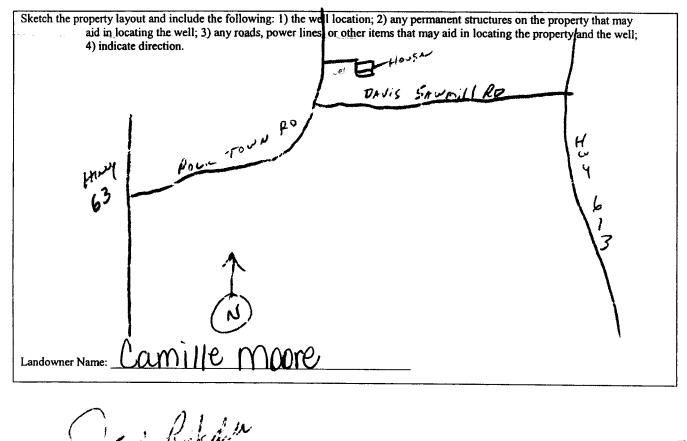

AUG 1 5 2006 BY: OLWR

STATE WELL REPORT						
CountyAJackSON Permit #: Driller (Dast Water Well SN. Date completed: 19-010	Part 2 Pump Installer's Completion Report Mississippi Department of Environmental Quality Office of Land and Water Resources		For Office Use Only: Aquifer: Well #: Elevation:			
This report should be prepared by the pump installer in detail and filed with the Department within 30 days of the installation of pump.						
Well Owner Informati Owner Name: Camille MO Mailing Address: POIKTOWN	B.d. S. <u>395</u> 22 Zip Code	Latitude: 30 43 370 23 Method of Lat/Long (circle one USGS quad, Hand-	held GPS, Survey-grade GPS <u>Z</u> Twn <u>745</u> Rng <i>R</i> 6 ω Nearest Town			
Pump Type Circle one			rer Type rcle one			
Air Lift Jet	Submersible	Diesel Engine Gasoline	e Engine Natural Gas			
Bucket Piston	Turbine (Electric Motor Hand	Tractor PTO			
Centrifugal Rotary	Flowing Well	Windmill Other (s	pecify):			
Other (specify):	0	Horse Power Rating of Motor:				
0.0	Gallons Per Minute	Setting Depth: 2017 . On Number of Stages:7				
Pump Test Data			suring Water Level cle one			
Date Well Tested: 7-20-06 Static Water Level (A): 65 Feet Below Land Surface Pumping Water Level (B): N/A Feet Below Land Surface		Air Line Electric Measu Other (specify):	uring Line Steel Tape			
Drawdown [(B) – (A)]: N Feet Below Land Surface		For flowing well, measured shut in head: NA feet				
Test Pumping Rate:	<u>_</u>	Well yielded7				
I HEREBY CERTIFY that the above statements are true to the best of my knowledge. <u>BED Bidgdell D-713P</u> <u>Bur Bidgdell</u> Print Name of Pump Installer and License No. (if applicable) <u>Signature of Pump Installer</u>						

AUG 1 5 2006 BY: OLWR