
State V	Vell Report		
	Part 1	For Office Use Only:	
Mississippi Departme	nt of Environmental Quality	Aquifer:	
	and Water Resources	Well #: _ C - 10 8	
Deillor 1773 T 177 T 17 T 17 T 17 T 1 T 1 T 1 T 1 T	Box 10631		
Jackson, I	MS 39289-0631)961-5210	L. S. Elevation:	
(601)3:	54-6938 (fax)	E-log #:	
State Law requires that this report be prepared by the 30 days of completion of drilling of the well.			
Well Owner Information	Well	Location	
Owner Name Lance Carlisle	Latitude: 30 • 42 533	" Longitude: (188 • 35 (173")	
Mailing Address: Old AMERICUS Rd.			
00 00 00 00 00	USGS quad Hand-held GPS, Survey-grade GPS		
MOSS POINT, MS 3915102- City State Zip Code		Twn 745 RngC6W	
Telephone No. (208) 218-1192 Distance Direction Nearest Town 4/2 Miles Nw of WADE			
Well	Data		
Purpose of Well (circle one Home Industrial Public Supply Irrigation Fish Culture Other:			
	well drilling completed:		
If flowing, method of flow regulation: Valve \(\sum \) Other (describe)		
Static Water Level: How feet above or below (circle one) land surface Date measured:			
Method of Measurement (circle one) steel tape electric tape	air line other:		
Hole depth: 308' Well depth: 308'	Well grouted to a depth of	10 feet	
Type of grout (circle one): Cement Bentonite Mix			
Casing length: 188 feet Casing diameter:	inches Type of casing:	DVC	
Screen length: 20 feet Screen diameter: 2	inches Type of screen:	PVC	
Screen slot size: -008 inches Setting depth: From -188 feet to -208 feet			
Type of completion (circle all applicable): Gravel packed Underreamed Telescoped Open hole Natural Development			
Other (describe):			
Top of lap pipe or reduction in casing:feet. If telescoped or more than one screen, describe on back of page			
Logs run (circle all applicable): No log run Electric Gamma Ray Density Sonic Neutron Other:			
Name of organization running log(s): NA			
I certify that the well was drilled, constructed, and completed in accordance with all applicable requirements of the Mississippi			
Department of Environmental Quality and/or the Mississippi Department of Health regulations and state laws.			
Jack Ridadell 0-472	Jack 1	GABECEIVED	
Print Name of Water Well Contractor and License No.	Signature of V	Water Well Company 18 2007	

If well telescopes please sketch below and show depths.

Ground Level		

Description of Formations Encountered	From	To
TOO SOIL	\cup	3
white corresamulpea Blue clay Gray course sand	12	09
Blue Clay	109	13
Gray Course Swig	10)	20
	+	
	1	†
		L
	 	
		ļ
		-
	 	
	+	
	 	
	-	
	+	
	 	
		لـــــــــــــــــــــــــــــــــــــ

If more than one screen, show location of each on sketch

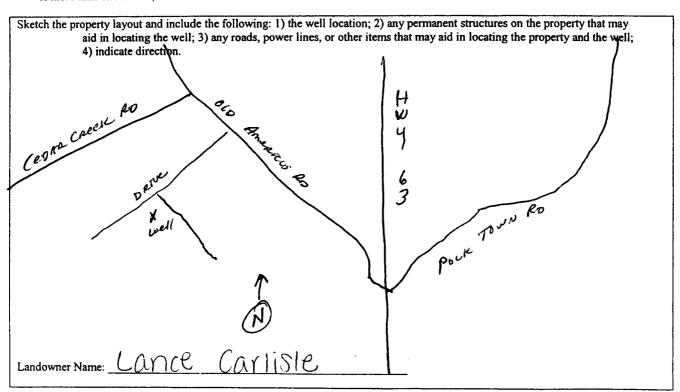

Signature of Water Well Contractor

RECEIVED

JAN 08 2007

BY: OLWE

STATE WELL REPORT

County: Jackson Permit #: Driller(Uast Water Well Srv.) Date completed: A - O - O C This report should be prepared by the installation of pump.

Part 2

Pump Installer's Completion Report
Mississippi Department of Environmental Quality
Office of Land and Water Resources
P.O. Box 10631
Jackson, MS 39289-0631
(601)961-5210

For Office Use Only:		
Aquifer:		
well #: <u>C - 108</u>		
Elevation:		

Date completed: 12 - 6 - 00	Jackson, MS 39289-0631 (601)961-5210			10.0	
Date completed: 121 W CQ	(601)35	4-6938 (fax)		Elevation:	
This report should be prepared by the installation of pump.	e pump installer in deta	il and filed with the	e Departmen	t within 30 day	ys of the
Well Owner Informat	ion		Well	Location	
Owner Name: Lanct Carll	·sle	Latitude: 30° 4	<u>J'532"</u> 1	Longitude: <u>D8</u>	18°35'673"
Mailing Address: Old Americ	us Rd.	Method of Lat/Long (circle one): Conventional Survey,		l Survey,	
		USGS	quad, (Hand-h	eld GPS, Surv	ey-grade GPS
MCSS Point M Sity State	S 39562 Zip Code	SW1/2 SW1/2 Sec 9 Twn T45 Rng R4		Rng RGW	
City State	Zip Code	Distance	Direction	Nearest Tov	⁄n
Telephone No. (2018) 218-1193	}	4/2 Miles NW of Wade		<u>, </u>	
Pump Type Circle one		Power Type Circle one			
Air Lift Jet	Submersible	Diesel Engine	Gasoline	Engine	Natural Gas
Bucket Piston	Turbine	Electric Motor	Hand		Tractor PTO
Centrifugal Rotary	Flowing Well	Windmill	Other (sp	ecify):	
Other (specify):		Horse Power Ratin	g of Motor: _	1/2 HP	
Date Pump Installed: 12-29-00		Setting Depth: 30 Ft. drop pipe feet		feet	
Rated Pump Capacity: 12	Gallons Per Minute	Number of Stages:			
Pump Test Data		34.	h-1-634		
Date Well Tested: 12-29-01	0	Method of Measuring Water Level Circle one		evei	
Static Water Level (A): Flow Feet I	· · · · · · · · · · · · · · · · · · ·	Air Line E	lectric Measur	ring Line	Steel Tape
	i	Other (specify):			
Pumping Water Level (B): N A Feet B	ŀ				
Drawdown [(B) – (A)]: NA Feet B	Below Land Surface	For flowing well, measured shut in head: NIA feet			
Test Pumping Rate: 12	Gallons Per Minute	Well yielded GPM with a drawdown of			
Duration of Pump Test (minimum 4 hours):	4 hours	NIA feet after NIA hours of pumping			

I HEREBY CERTIFY that the above statements are true to the best of r	ny knowledge	
Jack Ridgdell 0-472	Jan Rolphur	DEACH/FF
Print Name of Pump Installer and License No. (if applicable)	Signature of Pump Installer	RECEIVEL

JAN 18 2007

BY: OLWR