| • जगरू | | 113 |
|--|--|--------------------------|
| la llin | STATE WELL REPORT | For Office Use Only: |
| County: \underline{JUIMON} | Part 1 Driller's Log | well #: 0173 |
| Permit #: | Mississippi Department of Environmental Quality | Aquifer: |
| Driller: $\int P(eu)$ | Office of Land and Water Resources P.O. Box 2309 | E-Log #: |
| Date drilling completed: <u>//~//</u> | Jackson, MS 39225-2309 (601)961-5210 | |
| | (601)360-0535 (fax) | |
| | be prepared by the license holder responsible for the within 30 days of completion of drilling of the well of the set of | or borehole. |
| Well Owner Informat (Landowner if-borehole is not for | | hole Location |
| Owner Name: Tusne P | Latitude: 20-47-52 Lor | ngitude: <u>38-31-50</u> |
| Mailing Address: <u>36716</u> | A TELLA Method of Lat/Long (check one |): Conventional Survey, |
| mailing Address: <u>CROTE P</u> | USGS quad, Hand-held G | PS, Survey-grade GPS |
| Harles | 39517 DE SW 4 Ste NW 4, Sec | 42 × + 45 R/000 |
| Hulley VUS City State | Zin Code 6 Out | Hul ns |
| Telephone No. <u>251</u>) <u>610</u> - | 6911 (Distance) (Direction) | (Nearest Town) |
| | Well / Borehole Data | 1 |
| | drilling completed: $\frac{1}{10}$ Hole depth: $\frac{13}{20}$ | Hole diameter: |
| Location of the source of any surface v | water used for drilling: <u>Actuala</u> , WS | - All |
| Method of dosing and volume of Chlori | ne used in drilling and development: <u>2000</u> W | ater Sogal Black |
| Logs run (circle all applicable). No log | | |
| Name of organization running log(s): _ | | |
| Purpose of borehole (circle one). Water | · · · · · · · · · · · · · · · · · · · | Ground Source Heat Pump |
| Seisn | nic Survey Other (describe) | DECEIVE |
| If drilling is not rel | nic Survey Other (describe) lated to water well construction, skip the remainder Home Industrial Public Supply Irrigation | Fish Culture |
| Purpose of Well (circle all applicable) | Home Industrial Public Supply Irrigation | Fish Culture DEL 01 |
| Other (describe): | | BY OLV |
| If a flowing well, method of flow regu | lation: Valve Other (<i>describe</i>) | - |
| Static Water Level:fee | t [above or below] hand surface Date measured (circle one) | d: <u>11 - 10 - 18</u> |
| | Steel tape Electric tape Air line Other (describe) | |
| | a depth of: <u>10</u> feet Type of grout (<i>circle one</i>): | North I |
| Casing length: <u>120</u> feet C | asing diameter: <u>2</u> inches Type of e | casing: <u>llasti</u> |
| Screen length: <u>//</u> feet | Screen diameter:inches Type of | |
| Screen slot size: 10 inches | Setting depth: From | 0_ <u>130</u> _feet |
| Type of completion (circle all applicable | IC: Gravel packed Underreamed Open hole | Natural Development |
| Other (describe): | | |
| Top of lap pipe or reduction in casing: | feet | |
| If telesc | coped or more than one screen, describe on next pa | ge |

κ.

Form: OLWR-SWR-1A (4/13)

| County: Destant | SIAIL W | ELL REPORT | |
|--|---|---|--|
| County: Callman | | Part 2 | For Office Use Only: |
| Permit #: 0 - 780 | Pump Installe | er's Completion Report | |
| Driller: J Piene | Mississippi Departn | nent of Environmental Quality nd and Water Resources | Well #: |
| Date completed: _// - 10-18 | Р | .O. Box 2309 | |
| | | on, MS 39225-2309 | Aquifer: |
| Copy information from block on Part 1 | block on Part 1 (601)961-5210 (601) 360-0535 (fax) | | |
| This part of the report must be complete of the report must be attached and both | ed by a licensed water parts filed with the D | well contractor or a licensed pur Department at the above address w | np installer. A copy of Part 1 vithin 30 days of well completion. |
| Well Owner Informat | | | ocation gitude: <u>88 · 32 - 50</u> |
| Mailing Address: <u>26716 Pol</u> | ILTOW Rd | - · · |): Conventional Survey, |
| | | USGS quad, Hand-held G | PS, Survey-grade GPS |
| Hurles MD | 34562 | DE SW I Ito 14, Sec_ | 42 T.45 R.6W |
| Huly MD City State | Zip Code | 5 Miles North o | |
| Telephone No. (251) $(a/0 - b)$ | <u>. 7//</u> | (Distance) (Direction) | (Mearest Town) |
| | Pump Tvi | pe (circle one) | FCEIV |
| Submercible Turbine Air Lift Centrif | ugal Flowing Well | Tet Piston Rotary Other (de | scribe): REUL |
| Submersible Turbine Air Lift Centrif Date Pump Installed: (]() (2 | | Deted Dump Conscitute 11 | Callon DEC UT |
| Date Pump Installed: | <u>, </u> | Rated Pump Capacity: | Gallons Ref Minute |
| Is This Pump (circle one): Re | palleu replacemen | | <u>BX_UT</u> |
| | - | pe (circle one) | |
| Electric Diesel Gasoline Natural Gas | Tractor PTO Win | idmill Other (describe): | 7 |
| Horse Power Rating of Motor: | Setting Dept | th: <u>40 Kluu</u> feet Number | of Stages: |
| Date Well Tested:///0/ | • | for Non Flowing Well Duration of Pump Test (minim | num 4 hours): hours |
| Static Water Level (A): <u>3</u> Fee | t Below Land Surface | Pumping Water Level (B): _ | 40 Feet Below Land Surface |
| Drawdown [(B) - (A)]: | | | |
| | | | |
| | | and time) Other (describe): | - |
| | | | |
| Method of measurement (circle one): S | Pump Test Da | ape Air line) Other (<i>describe</i>): ta for Flowing Well | |
| Method of measurement (<i>circle one</i>): S Measured shut in head:feet | Pump Test Da | ta for Flowing Well | |
| Method of measurement (<i>circle one</i>): S Measured shut in head:feet | Pump Test Da | ta for Flowing Well | |
| Method of measurement (<i>circle one</i>): S Measured shut in head:feet | Pump Test Da t. drawdown of | ta for Flowing Well | |
| Method of measurement (<i>circle one</i>): S Measured shut in head:feet Well yieldedGPM with a | Pump Test Da t. drawdown of Meter | ta for Flowing Well feet after Installation | _hours of pumping |
| Method of measurement (<i>circle one</i>): S Measured shut in head:feet Well yieldedGPM with a Meter Manufacturer: | Pump Test Da t. drawdown of Meter | ta for Flowing Well feet after Installation Meter Serial Number: | _hours of pumping |
| Method of measurement (circle one): S Measured shut in head:feet Well yieldedGPM with a Meter Manufacturer: Meter Model Number/Name: | Pump Test Da t. drawdown of Meter | ta for Flowing Well feet after Installation Meter Serial Number: Type of Meter: | _hours of pumping |
| Method of measurement (<i>circle one</i>): S Measured shut in head:feet Well yieldedGPM with a Meter Manufacturer: | Pump Test Da t. drawdown of Meter factor (AF x .001, ga | ta for Flowing Well feet after Installation Meter Serial Number: Type of Meter: l x 1000, etc): | _hours of pumping |
| Method of measurement (circle one): S Measured shut in head:feet Well yieldedGPM with a Meter Manufacturer: Meter Model Number/Name: Totalizer Register Unit and Multiplier F | Pump Test Da | ta for Flowing Well feet after Installation Meter Serial Number: Type of Meter: l x 1000, etc): | _hours of pumping |
| Method of measurement (circle one): S Measured shut in head:feet Well yieldedGPM with a Meter Manufacturer: Meter Model Number/Name: Totalizer Register Unit and Multiplier F Installation Date: Is This Meter (circle one): New Refered to the paper in the paper in the shore | Pump Test Da t. drawdown of Meter factor (AF x .001, ga Meter installed by: epaired Replacem information you are c | ta for Flowing Well feet after Installation Meter Serial Number: Type of Meter: l x 1000, etc): ent | _hours of pumping |
| Method of measurement (circle one): S Measured shut in head:feet Well yieldedGPM with a Meter Manufacturer: Meter Model Number/Name: Totalizer Register Unit and Multiplier F Installation Date: Is This Meter (circle one): New Refered to the paper in the paper in the shore | Pump Test Da t. drawdown of Meter factor (AF x .001, ga Meter installed by: epaired Replacem information you are c ural wells, a list of ap | ta for Flowing Well | _hours of pumping |


Form: OLWR-SWR-1B (4/13)

| · | | |
|-----------|---------|---|
| County: | Jaskion | |
| Permit #: | 0-780 | - |
| | | |

| | For | Office | Use | Only: |
|------|-----|--------|-----|-------|
| Well | #: | CIT | 3 | |

The sketch below only required for water wells

If well telescopes, show depths on sketch.

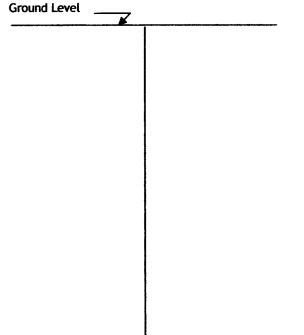

Description of formations encountered must be provided for all wells and boreholes, unless specifically exempted by regulations

| Description of Formations Encountered | From (depth) | To (depth) |
|---------------------------------------|--------------|------------|
| | Ground level | |
| | | |
| $\rho \rho \rho$ | | |
| Ned Jane | 0 | 25 |
| | | |
| | | |
| Clay | 25 | 40 |
| 0 | | |
| | | |
| Sand | 40 | 130 |
| | | |
| | | |
| | | |
| | | JED- |
| | | EIV CC |
| | REU | - 2018 |
| | nef | 01 00. |
| | UEC | - NR |
| | | OLV. |
| | BY | <u> </u> |
| | | l |

If more than one screen, show location of each on sketch

