

Jackson

121

STATE WELL REPORT

Part 1

Driller's Log

Mississippi Department of Environmental Quality
Office of Land and Water Resources
P.O. Box 2309
Jackson, MS 39225-2309
(601)961-5210
(601)360-0535 (fax)

For Office Use Only:

Well #: C 174
Aquifer: _____
E-Log #: _____

County: DeWitt
Permit #: 0-780
Driller: J Pious
Date drilling completed: 1-27-19

State Law requires that this report be prepared by the license holder responsible for the work and filed with the Department at the above address within 30 days of completion of drilling of the well or borehole.

Well Owner Information (Landowner if borehole is not for a water well)	Well or Borehole Location
Owner Name: <u>Louis Houss II</u>	Latitude: <u>30-43-13</u> Longitude: <u>88-32-42</u>
Mailing Address: <u>2465 Polk Town Rd</u>	Method of Lat/Long (check one): Conventional Survey _____, 32.28 53
<u>Lucedale</u> MS <u>39452</u>	USGS quad _____, Hand-held GPS <input checked="" type="checkbox"/> , Survey-grade GPS _____
City State Zip Code	<u>NE 1/4 SW 1/4</u> Sec <u>2</u> T <u>45</u> R <u>6W</u>
Telephone No. <u>228</u> <u>990-0611</u>	<u>6 1/2</u> Miles <u>SW</u> of <u>Aquila, MS</u>
	(Distance) (Direction) (Nearest Town)

Well / Borehole Data	
Date drilling started: <u>1-27-19</u>	Date drilling completed: <u>1-27-19</u> Hole depth: <u>35</u> Hole diameter: <u>2</u>
Location of the source of any surface water used for drilling: <u>Aquila, MS</u>	
Method of dosing and volume of Chlorine used in drilling and development: <u>2000 Water 5 gal Bleach</u>	
Logs run (circle all applicable): <input checked="" type="checkbox"/> No log run <input type="checkbox"/> Electric <input type="checkbox"/> Gamma Ray <input type="checkbox"/> Density <input type="checkbox"/> Sonic <input type="checkbox"/> Neutron <input type="checkbox"/> Other: _____	
Name of organization running log(s): _____	
Purpose of borehole (circle one): <input checked="" type="checkbox"/> Water Well <input type="checkbox"/> Geotechnical/Geological Investigation <input type="checkbox"/> Ground Source Heat Pump	
Seismic Survey <input type="checkbox"/> Other (describe) _____	
If drilling is not related to water well construction, skip the remainder of this block	
Purpose of Well (circle all applicable): <input checked="" type="checkbox"/> Home <input type="checkbox"/> Industrial <input type="checkbox"/> Public Supply <input type="checkbox"/> Irrigation <input type="checkbox"/> Fish Culture	
Other (describe): _____	
If a flowing well, method of flow regulation: Valve _____ Other (describe) _____	
Static Water Level: <u>2</u> feet [above <input checked="" type="checkbox"/> or below <input type="checkbox"/> land surface] Date measured: <u>1-29-19</u>	
Method of measurement (circle one): Steel tape <input type="checkbox"/> Electric tape <input type="checkbox"/> <input checked="" type="checkbox"/> Air line <input type="checkbox"/> Other (describe): _____	
Well depth: <u>35</u> Well grouted to a depth of: <u>10</u> feet Type of grout (circle one): Neat Cement <input type="checkbox"/> <input checked="" type="checkbox"/> Bentonite <input type="checkbox"/> Mix	
Casing length: <u>30</u> feet	Casing diameter: <u>2</u> inches Type of casing: <u>Plastic</u>
Screen length: <u>5</u> feet	Screen diameter: <u>2</u> inches Type of screen: <u>Plastic</u>
Screen slot size: <u>10</u> inches	Setting depth: From <u>0</u> feet to <u>35</u> feet
Type of completion (circle all applicable): <input checked="" type="checkbox"/> Gravel packed <input type="checkbox"/> Underreamed <input type="checkbox"/> Open hole <input type="checkbox"/> Natural Development	
Other (describe): _____	
Top of lap pipe or reduction in casing: _____ feet	
If telescoped or more than one screen, describe on next page	

Jackson

STATE WELL REPORT

Part 2

Pump Installer's Completion Report

Mississippi Department of Environmental Quality

Office of Land and Water Resources

P.O. Box 2309

Jackson, MS 39225-2309

(601)961-5210

(601) 360-0535 (fax)

For Office Use Only:

Well #: CJ7A

Aquifer: _____

County: George

Permit #: 0-780

Driller: J. Pinal

Date completed: 1-29-19

Copy information from block on Part 1

This part of the report must be completed by a licensed water well contractor or a licensed pump installer. A copy of Part 1 of the report must be attached and both parts filed with the Department at the above address within 30 days of well completion.

Well Owner Information	Well Location
Owner Name: <u>Lewis Homes IIc</u>	Latitude: <u>30-43-13</u> Longitude: <u>88-32-42</u>
Mailing Address: <u>2465 Park Town Rd</u>	Method of Lat/Long (check one): Conventional Survey <input type="checkbox"/> ^{3, 2, 25} <u>50</u>
<u>Unedale</u> <u>MS</u> <u>39452</u>	USGS quad _____, Hand-held GPS <input checked="" type="checkbox"/> , Survey-grade GPS _____
City State Zip Code	<u>NE</u> $\frac{1}{4}$ <u>SW</u> ^{SE} $\frac{1}{4}$, Sec <u>2</u> T <u>45</u> R <u>6W</u>
Telephone No. <u>(228) 990-0611</u>	<u>6 1/2</u> Miles <u>SW</u> of <u>Acquaha, MS</u>
	(Distance) (Direction) (Nearest Town)

Pump Type (circle one)

Submersible Turbine Air Lift Centrifugal Flowing Well Jet Piston Rotary Other (describe): _____

Date Pump Installed: 1-23-19 Rated Pump Capacity: 8 Gallons Per Minute

Is This Pump (circle one): New Repaired Replacement

Power Type (circle one)

Electric Diesel Gasoline Natural Gas Tractor PTO Windmill Other (describe): _____

Horse Power Rating of Motor: 1 Setting Depth: 20 feet Number of Stages: 2

Pump Test Data for Non Flowing Well

Date Well Tested: 1-23-19 Duration of Pump Test (minimum 4 hours): 48 hours

Static Water Level (A): 2 Feet Below Land Surface Pumping Water Level (B): 20 Feet Below Land Surface

Drawdown [(B) - (A)]: 2 Feet Below Land Surface Test Pumping Rate: 8 Gallons Per Minute

Method of measurement (circle one): Steel tape Electric tape Air line Other (describe): _____

Pump Test Data for Flowing Well

Measured shut in head: _____ feet.

Well yielded _____ GPM with a drawdown of _____ feet after _____ hours of pumping

Meter Installation

Meter Manufacturer: _____ Meter Serial Number: _____

Meter Model Number/Name: _____ Type of Meter: _____

Totalizer Register Unit and Multiplier Factor (AF x .001, gal x 1000, etc): _____

Installation Date: _____ Meter installed by: _____

Is This Meter (circle one): New Repaired Replacement

Important: By submitting the above information you are certifying that this meter was installed to manufacturer standards. For agricultural wells, a list of approved meters is on the MDEQ website.

I HEREBY CERTIFY that the above statements are true to the best of my knowledge.

Print Name: _____	License No. (if applicable): _____	Date: _____	Signature of Pump Installer: _____
Well #: _____	Driller's Log: _____	Permit #: _____	County: _____


Jackson

County: Adams
 Permit #: 0-780

For Office Use Only:
 Well #: C174

The sketch below only required for water wells


If well telescopes, show depths on sketch.

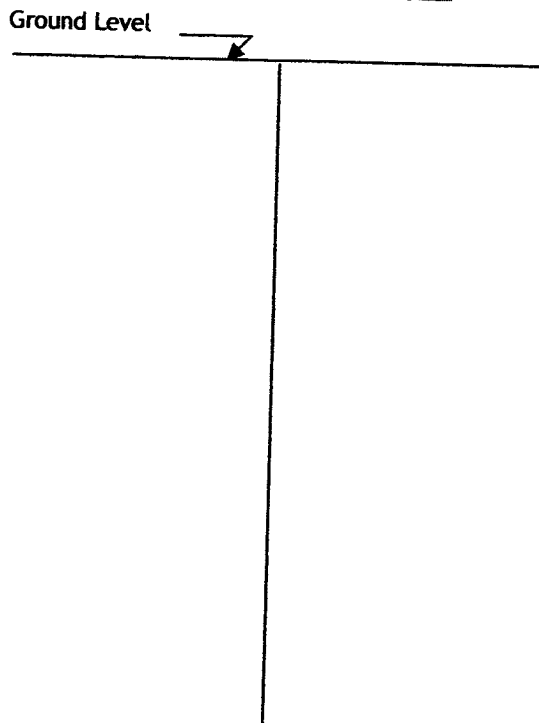

Description of formations encountered must be provided for all wells and boreholes, unless specifically exempted by regulations

Description of Formations Encountered	From (depth) Ground level	To (depth)
<u>Sand & Gravel</u>	<u>0</u>	<u>35</u>

If more than one screen, show location of each on sketch

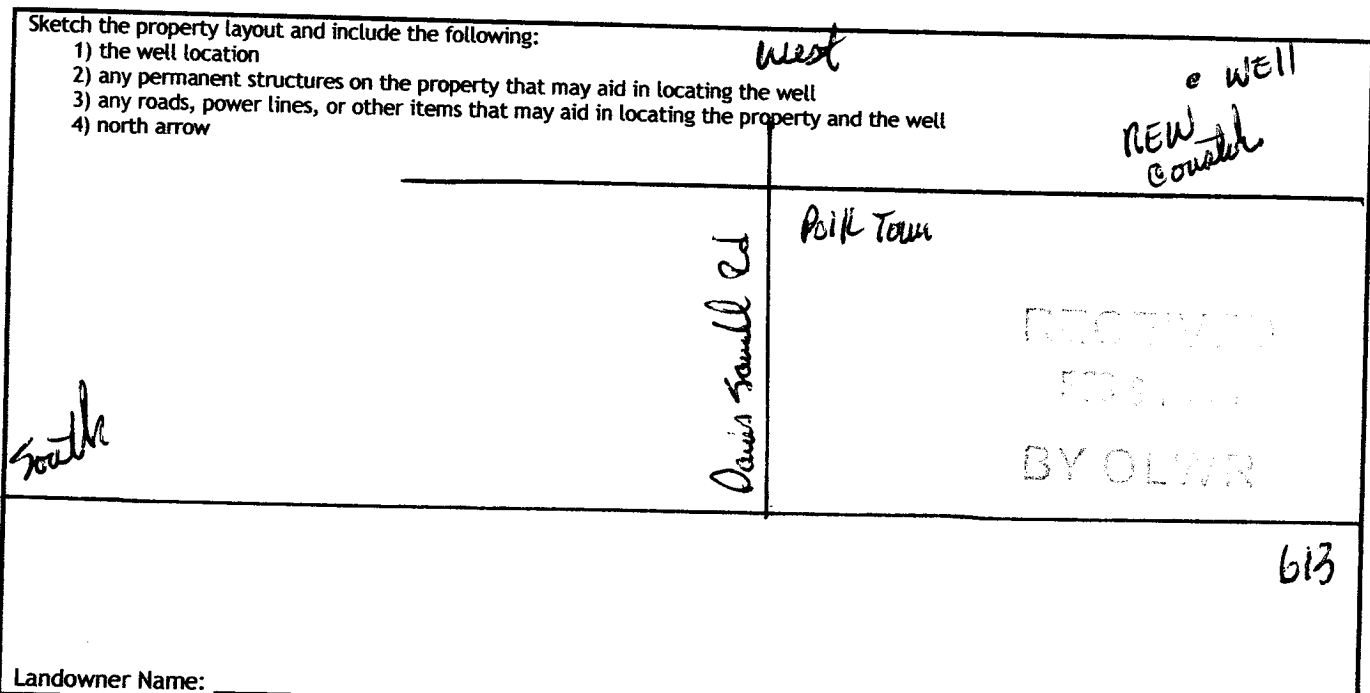

Landowner Name: _____

I HEREBY CERTIFY that the well/borehole was drilled, constructed, and completed in accordance with all applicable requirements of the Mississippi Department of Environmental Quality and the Mississippi Department of Health regulations, if applicable, and state laws.

Joel Pierre 0-780 1-23-19 Joel Pierre
 Print Name of Responsible Licensee and License No. Date Signature of Licensee